

Russell KANSAS

Sec. 4 Twp. 15 R. 12W

Well No. #10 Cook Farm _____

Cities Service Company _____

Contractor _____

Hall-Gurney


_____ Ft. from N. Line

330' Ft. from S. Line

990' Ft. from E. Line

_____ Ft. from W. Line

SW SE SE

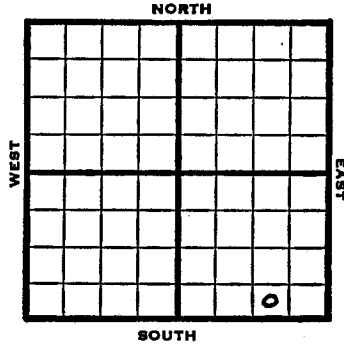


KANSAS Russell

Section 4 Township 15 Range 12-W

Well No. #10 Cook

Company Cities Service

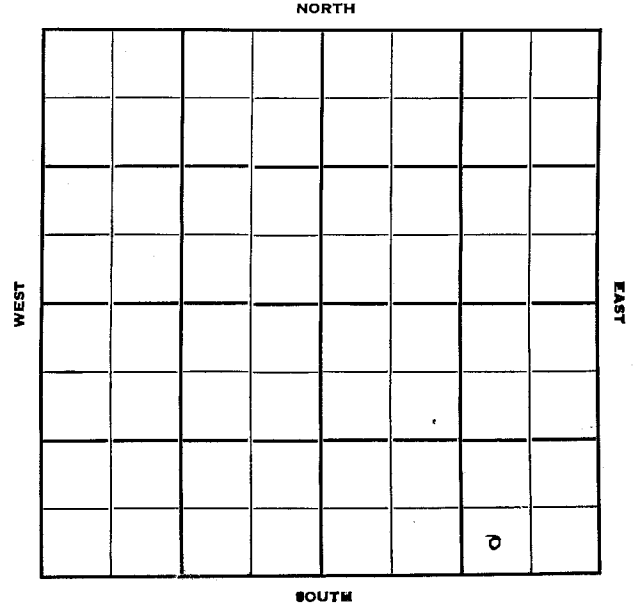

1950 Elev 1858 REPORT

8/16 Location

9/20 8" @ 727

Heeb 2925

Dodge 2942

Lans 3005

Gorham 3297

5" @ 3298

TD 3323 FU 350' water 2 1/2 hr PB 3218

51/3094-3108 2000 A 18/3073-78

41/3034-45 1000A

Comp. 150 bopd 109 bw

Completed

COMPLETED