

Russell

KANSAS

Map No. 55 Sec. 4 Twp. 15 R. 12W

Well No. 6 Cook

Cities Service Oil Company

FIRST REPORT Contractor

NE SE SE

SECTION PLAT

			o

Ft. from N. Line

990 Ft. from S. Line

330 Ft. from E. Line

Ft. from W. Line

Hall-Gurney Pool

Location X

Rig up

Drilling and Remarks:

RECORD

Cased in, ft.

Sand

Gas

Oil

Total Depth

PRODUCTION

1st 24 hrs. Nat.

1st 24 hrs. after shot

Gas Cu. Ft.

Dry Hole

Abandoned

Date

FEB 23 1944 19

S. J. LEWIS Scout

Pool Name Hall-Gurney

KANSAS

Map No. 55 Sec. 4 Twp. 15 R. 12W

Well No. 6 Cook

Cities Service Oil Company

COMPLETED Contractor

NE SE SE

SECTION PLAT

			o

Ft. from N. Line

990 Ft. from S. Line

330 Ft. from E. Line

Ft. from W. Line

Russell County

Location

Rig up

Drilling and Remarks:

Got hole 3282
4" @ 3283

Pump 229 P.S.

3838

RECORD

Cased in, ft.

Sand

Gas

Oil

Total Depth 3294

PRODUCTION

1st 24 hrs. Nat.

1st 24 hrs. after shot

Gas Cu. Ft.

Dry Hole

Abandoned

Date

MAY 3 1944 19

S. J. LEWIS Scout

Russell

Sec. 4 Twp. 15 R. 12W

Well No. #6 Cook Farm

Cities Service Oil Company

Hall-Gurney


 Ft. from N. Line

990 Ft. from S. Line

330 Ft. from E. Line

 Ft. from W. Line

Nov. 1851

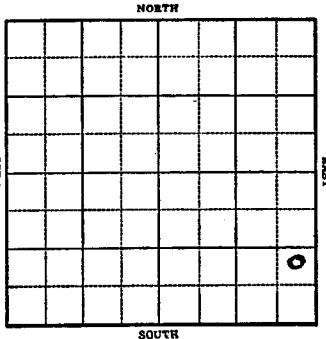

REPORT

1944	
2/23	Location
3/1	8" @ 110 WOC.
3/8	Drlg. 2810
3/16	Drilling 3132
3/22	Lans 3003 Gorhan 3288-90 TD 4" @ 3289 Rust
3/29	"
4/5	"
4/12	"
4/19	TD 3294 125' oil 1 hr 1750' oil in 6 hrs.
4/26	" " "
5/3	5" @ 3283 Gorhan 3282 Td 3294 Pump 229 Pot Gravity 38.3
	COMPLETED

Russell

Section 4 Township 15 Range 12W

Well No. #6 Cook

Company Cities Service Oil

