

Map No. 55 Sec. 4 Twp. 15 R. 12W

Well No. 1-Kuhnle "A"

Jones & Shelbourne Company

Contractor

**FIRST REPORT**


**NW NE SW SECTION PLAT**

330 Ft. from N. Line

\_\_\_\_\_ Ft. from S. Line

990 Ft. from E. Line

\_\_\_\_\_ Ft. from W. Line

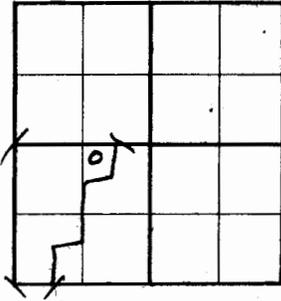

Location \_\_\_\_\_

**RECORD**

Cased \_\_\_\_\_ in., \_\_\_\_\_ ft.

Sand \_\_\_\_\_

Gas \_\_\_\_\_

Oil \_\_\_\_\_

Total Depth \_\_\_\_\_

**PRODUCTION**

1st 24 hrs. Nat. \_\_\_\_\_

1st 24 hrs. after shot \_\_\_\_\_

Gas \_\_\_\_\_ Cu. Ft.

Dry Hole \_\_\_\_\_

Abandoned \_\_\_\_\_

Rig up \_\_\_\_\_  
Drilling and Remarks:

15" 480

Anhy 740

12" 747

10" 2015

Show gas 2340-50

Drlg 2350

Date

OCT 20 1933

H. D. Hatfield

Scout

Map No. 55 Sec. 4 Twp. 15 R. 12W

Well No. 1 Kuhnle "A"

Jones & Shelbourne Company

Contractor

**COMPLETED**


**SECTION PLAT**

330 Ft. from N. Line

\_\_\_\_\_ Ft. from S. Line

990 Ft. from E. Line

\_\_\_\_\_ Ft. from W. Line

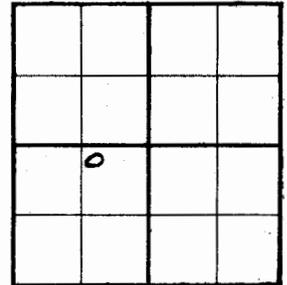

Location \_\_\_\_\_

**RECORD**

Cased 6 in., 3282 ft.

Sand Gorham 3267

Gas \_\_\_\_\_

Oil \_\_\_\_\_

Total Depth 3288

**PRODUCTION**

1st 24 hrs. Nat. \_\_\_\_\_

1st 24 hrs. after shot \_\_\_\_\_

Gas \_\_\_\_\_ Cu. Ft.

Dry Hole \_\_\_\_\_

Abandoned \_\_\_\_\_

Rig up \_\_\_\_\_  
Drilling and Remarks:

2500 Acid

POT ~~393~~ oil  
670 WTR

Date

NOV 30 1938

H. D. Hatfield Scout

KANSAS

Russell

Sec. 4 Twp. 15 R. 12-W

Well No. #1 Kuhale 7A Farm


Jones & Shelbourne Company

330 Ft. from N. Line

\_\_\_\_\_ Ft. from S. Line

990 Ft. from E. Line

\_\_\_\_\_ Ft. from W. Line

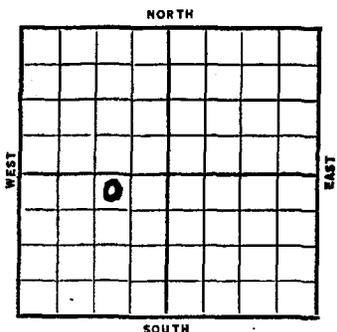

1938

11/30

6" - 3282'.

Gorham 3267'.

T. D. 3288'.

2500 acid.

Potential 393 oil.

6% water.

COMPLETED

Date	REPORT
1938	
10/26	15" - 480'. Anhy. 740'.
	12" - 747'. 10" - 2015'.
	Show gas 2340-50'.
	Drlg. 2350'.
11/4	Topeka 2610'. 8" - 2590'.
	Dlg. 2805'.
11/12	Lans. 2973'. Oil Pay 3011-20'.
	1 1/2 B. W. 3085'. T.D. 3105'.
	No oil. P. B. 3040'.
11/18	6" - 3036'. S. O. & W. 3073-87'.
	S. O. 3120-25'. Dlg. 3255'.
11/25	Gorham 3267'. Pay 3282-88'.
	2700' oil in 15 hrs.
	Grav. 40 @ 64'. U. R. 6".
	OVER

KANSAS Russell

Section 4 Township 15 Range 12-W

Well No. #1 Kuhnle "A"

Company Jones & Shelbourne

