

Map No. _____ Sec. 4 Twp. 15 R. 12WWell No. 11 KuhnleJones & Shelborne Company**FIRST REPORT**

Contractor

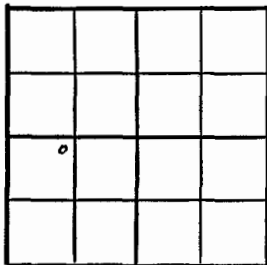
NE NW SW

SECTION PLAT

330 Ft. from N. Line

_____ Ft. from S. Line

_____ Ft. from E. Line

990 Ft. from W. Line

Russell County

Location X

Rig up _____

Drilling and Remarks:

RECORD

Cased _____ in., _____ ft.

Sand _____

Gas _____

Oil _____

Total Depth _____

PRODUCTION

1st 24 hrs. Nat. _____

1st 24 hrs. after shot _____

Gas _____ Cu. Ft.

Dry Hole _____

Abandoned _____

Date

JAN 8 1947 S. J. LEWIS ScoutMap No. 55 Sec. 4 Twp. 15 R. 12WWell No. 11 KuhnleJones & Shelborne Company**COMPLETE**

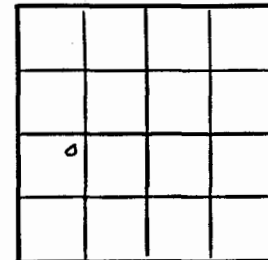
Contractor

NE NW SW

E1,1802
SECTION PLAT330 Ft. from N. Line

_____ Ft. from S. Line

_____ Ft. from E. Line

990 Ft. from W. Line

Russell County

Location _____

Rig up _____

Drilling and Remarks:

Lions 29425' @ 3080Pump 4302 L + 50% W

RECORD

Cased _____ in., _____ ft.

Sand _____

Gas _____

Oil _____

Total Depth 2942

PRODUCTION

1st 24 hrs. Nat. _____

1st 24 hrs. after shot _____

Gas _____ Cu. Ft.

Dry Hole _____

Abandoned _____

Date

JUN 25 1947 S. J. LEWIS Scout

Russell County ✓

Sec. 4 Twp. 15 R. 12W

Well No. 11 Kuhnle Farm

Jones & Shelborne Company

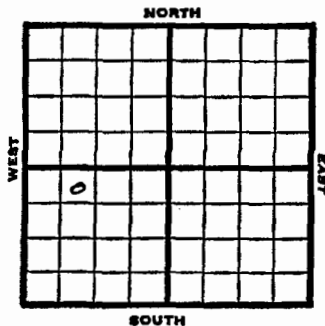
Hall-Gurney Pool

330 Ft. from N. Line

Ft. from S. Line

990 Ft. from E. Line

Ft. from W. Line



NE NW SW

1947	Elev. 1802'	REPORT
1/8	Location	
1/15	Rig	
1/21	"	
1/30	"	
2/5	"	
2/12	Drlg 445'	
2/19	13" @ 724' Drlg 1405'	
2/26	10" @ 1984' Drlg 2000'	
3/4	Drlg 2275'	
3/11	8" @ 2400 Drlg 2780'	
3/18	Lans 2932 7" @ 2932 Drlg 3000'	
3/25	TD 3080' 250' oil & 750' water	
OVER		

4/2 5" @ 3080'
P.B.P.

4/9 " "

4/15 Pump 29 oil & 12 W in 8 hrs.

4/23 " " "

4/29 " " "

5/7 " " "

5/13 " " "

5/20 1/2 " "

5/27 " " "

6/3 " " "

6/10 " " "

6/17 " " "

6/25 TD 3082'
Lansing 2942'
5" @ 3080'
Pump 43 oil & 50% water
Gr. 40.3
Complete
COMPLETED

KANSAS

Russell county

Section 4 Township 15 Range 12-W

Well No. #11, Kuhnle

Company Jones and Shelborne

