

Map No. 4-55 Sec. 4 Twp. 15 R. 12WWell No. 7 KuhnleJones & Shelborne Company

Contractor


FIRST REPORT

NE SW SW

 Ft. from N. Line990 Ft. from S. Line Ft. from E. Line990 Ft. from W. Line

GREENVALE POOL

SECTION PLAT

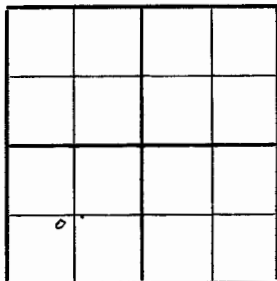

Location	RECORD	
	Cased	in., ft.
Rig up	Sand	
Drilling and Remarks:	Gas	
	Oil	
	Total Depth	
	PRODUCTION	
Cellar	1st 24 hrs. Nat.	
	1st 24 hrs. after shot	
	Gas	Cu. Ft.
	Dry Hole	
	Abandoned	

Date

OCT 1 1941 19 S. J. LEWIS ScoutMap No. 55 Sec. 4 Twp. 15 R. 12WWell No. 7 KuhnleJones & Shelborne Company

Contractor


COMPLETED

NE SW SW

 Ft. from N. Line990 Ft. from S. Line Ft. from E. Line990 Ft. from W. Line

GREENVALE POOL

SECTION PLAT

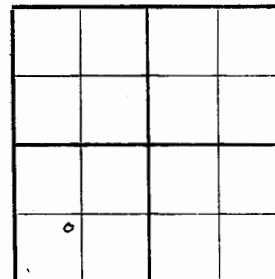

Location	RECORD	
	Cased	in., ft.
Rig up	Sand	
Drilling and Remarks:	Gas	
	Oil	
	Total Depth	
	PRODUCTION	
Loss 2970 7" C 3035 800 gal Brn & Pr 2220 ft + 26% Water 356 gal	1st 24 hrs. Nat.	
	1st 24 hrs. after shot	
	Gas	Cu. Ft.
	Dry Hole	
	Abandoned	

Date

APR 22 1942 19 S. J. LEWIS Scout

KANSAS**Russell**Sec. 4 Twp. 15 R. 12-WWell No. #7 Kuhnle FarmJones & Shelborne Company
(Greenville)


Ft. from N. Line

990 Ft. from S. Line

Ft. from E. Line

990 Ft. from W. Line

Elev. 1813

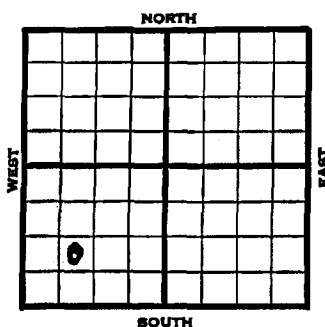

1941	REPORT
10/1	Cellar.
10/9	"
10/16	"
10/23	"
10/30	"
11/6	"
11/13	Cable rig.
11/20	Spud.
11/26	15" - 470' Anhy 725'
	13" - 735' Drlg. 840'
12/4	Drlg. 1775'
12/11	10" @ 2005 2440 fsg.
12/18	2445 Run 8"
12/24	8" - 2465' T.D. 3040' 7" - 3035'
	1100' oil.
12/31	" "
1942	
1/8	T.D. 3043' 1500' oil 3 hours.
	8000 acid. Shut down.
1/15	" " " "
1/22	" " " "
	OVER

1942

1/29

TD 3043' 1500' oil 3 hours.
8000 acid.
Shut down.

2/5

" "

2/12

" "

2/19

" "

2/26

" "

3/5

" "

3/12

" "

3/19

" "

3/26

" "

4/2

" "

4/8

Temp. Potential 15 bbls., pump.

4/15

" " "

4/22

Lans. 2970'

7" - 3035'

T.D. 3043'

8000 acid.

Bomb potential 2220 oil & 26% water.

38.6 Gravity

COMPLETED

FORM 51 5M 4-41 PETROL

Section 4 Township 15 Range 12-W
Well No. 7 Kuhnle
Company Jones & Shelborne

NORTH Greenvale Pool

WEST

EAST

SOUTH

0