

Russell KANSAS

Map No. 55 Sec. 4 Twp. 15 R. 12WWell No. 1 Kuhnle

Central Petroleum Company

Contractor

FIRST REPORT

NE SW

330 Ft. from N. Line

Ft. from S. Line

330 Ft. from E. Line

Ft. from W. Line

SECTION PLAT

	0		

Location

RECORD

Cased in., ft.

Sand

Gas

Oil

Total Depth

PRODUCTION

1st 24 hrs. Nat.

1st 24 hrs. after shot

Gas Cu. Ft.

Dry Hole

Abandoned

Date

JUL 6 - 1938 19 H. D. Hatfield Scout

Russell KANSAS

Map No. 55 Sec. 4 Twp. 15 R. 12WWell No. 1 Kuhnle

Central Petroleum Company

Contractor

COMPLETED

NE SW

330 Ft. from N. Line

Ft. from S. Line

330 Ft. from E. Line

Ft. from W. Line

SECTION PLAT

	0		

Location

RECORD

Cased 6 in., 3061 ft.Sand LENS 2978

Gas

Oil

Total Depth 3067

PRODUCTION

1st 24 hrs. Nat.

1st 24 hrs. after shot

Gas Cu. Ft.

Dry Hole

Abandoned

Date

AUG 17 1938 19 H. D. Hatfield Scout

$P = 118/4 + 92/4$
 Pot 551
 gas 36.1/74

Russell

Sec. 4 Twp. 15 R. 12-W

Well No. #1 Kuhnle Farm

Central Petr. Sales Company

C. W. S. D.


820 Ft. from N. Line

Ft. from S. Line

330 Ft. from E. Line

Ft. from W. Line

Elev. 1833

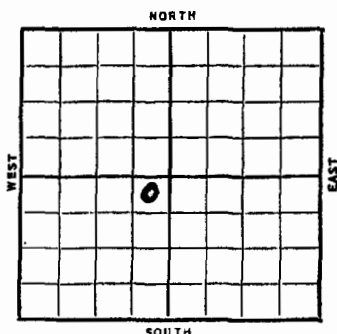[illegible]

1938

8/17

6" at 3061'.

Lans. 2978'.

T. D. 30671.

Pump 118 bbls. 4 hrs. & 92

bbls. 4 hrs.

Potential 551 bbls.

Gravity 36.1/74.

COMPLETED

1950

5/31

Lan. 29/84

OTD 3067

6" @ 3060'

Drig. 3100

1950

7/19

Lans 2978

OTD 3067

6" @ 3060

FU 511' oil @ 3268

Set 239' of 5" liner

@ 3267

S/2 1/3 boph 4 hrs

S 2 3/4 boph 4 hr

S/3 boph 12 hr

FU 1425' oil 19 hr

Lime 3267

TD 3269

Comp 70 bopd

FIRST REPORT

COMPLETED


COMPLETED

OWDD

Map No. _____ Sec. 4 Twp. 15 R. 12W
 Well No. 1 Kunkle **FIRST REPORT**
Sohio **COMPLETED** Company

NE NE SW Contractor
 El. 1833
 SECTION PLAT

330 Ft. from N. Line
 _____ Ft. from S. Line
330 Ft. from E. Line
 _____ Ft. from W. Line

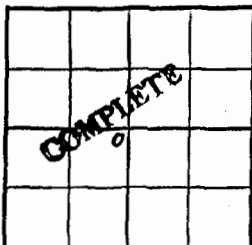

Russell County

Location _____	RECORD
Rig up _____	Cased _____ in. _____ ft.
Drilling and Remarks:	Sand _____
Lans. 2978	Gas _____
OTD 3067	Oil _____
6" @ 3060	Total Depth <u>3269</u>
FU 511' oil @ 3268	PRODUCTION
Set 239' of 5" line	1st 24 hrs. Nat. _____
@ 3267	24 hrs. after shot _____
S/ 2 1/3 boph 4 hr.	Gas _____ Cu. Ft.
S/ 2 3/4 boph 4 hr.	Abandoned _____

Date

JUL 19 1950

JUL 19 1950

J. L. TYRA

Scout

S/ 3 boph 12 hr.

FU 1425' oil 19 hr.

Line 3267

TD 3269

Comp. 70 bopd

AUG 7 1950

O.W.D.D

Map No. _____ Sec. 4 Twp. 15 R. 12WWell No. 1 Kuhnle

Schio _____ Company _____

NE NE SW _____ Contractor E1.1833

SECTION FLAT

330 Ft. from N. Line

Ft. from S. Line

330 Ft. from E. Line

Ft. from W. Line

Russell

Location _____

Rig up _____

Drilling and Remarks:

Lan. 2978

OT. D. 3057

6" @ 3060

Drlg. 3100

RECORD

Cased _____ in, _____ ft.

Sand _____

Gas _____

Oil _____

Total Depth _____

PRODUCTION

1st 24 hrs. Nat. _____

1st 24 hrs. after shot _____

Gas _____ Cu. Ft.

Dry Hole _____

Abandoned _____

Date

MAY 31 1950J. E. TYRA Scout


Russell

KANSAS

O.W.D.D

Section 4 Township 15 Range 12-WWell No. #1 KuhnleCompany Central Petr. Schio

NORTH

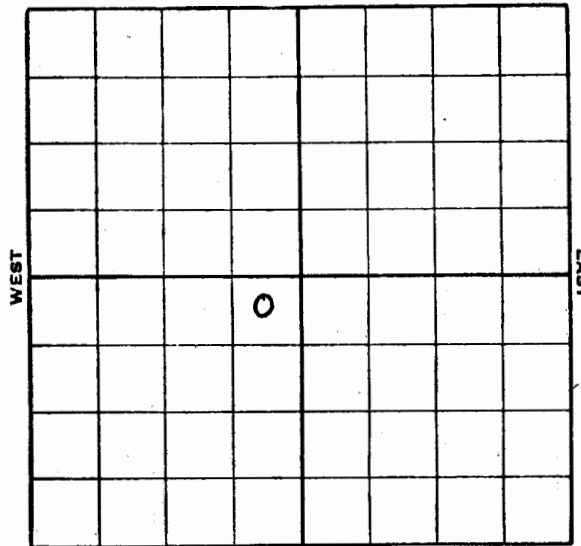

SOUTH

O.W.D.D