Form 26 200 Blks. 11-49 Petrol

Kansas

Hall-Gurney Pool

Map No. ____ Sec. 5 Twp. 15 R. 12W


Well No. 10 F. Veill

Shell Company

B & R Drlg. Contractor

NE NE NW

SECTION PLAT

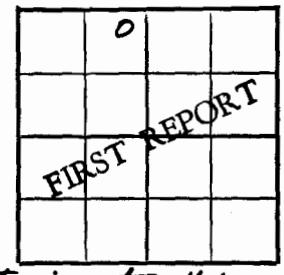

330 Ft. from N. Line

Ft. from S. Line

390 Ft. from E. Line

Ft. from W. Line

Russell County

twin to #1

Location x

Rig up

Drilling and Remarks:

RECORD

Cased in., ft.

Sand

Gas

Oil

Total Depth

PRODUCTION

1st 24 hrs. Nat.

1st 24 hrs. after shot

Gas Cu. Ft.

Dry Hole

Abandoned

Date

MAY 3 1950 19

J. E. TYRA Scout

Form 26 200 Blks. 11-49 Petrol

Hall-Gurney Pool

Kansas

Map No. ____ Sec. 5 Twp. 15 R. 12W

Well No. 10 F. Veill


Shell Company

Contractor

NE NE NW

El. 1766

SECTION PLAT

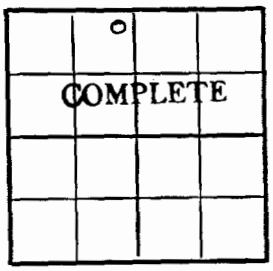

330 Ft. from N. Line

Ft. from S. Line

330 Ft. from E. Line

Ft. from W. Line

Russell

Location

Rig up

Drilling and Remarks:

8" @ 698
Lans 2936
4½" @ 3069
perf 64/3029-45
" 168/2981-3023
83 BOPD
+ 23 BWPD

RECORD

Cased in., ft.

Sand

Gas

Oil

Total Depth

PRODUCTION

1st 24 hrs. Nat.

1st 24 hrs. after shot

Gas Cu. Ft.

Dry Hole

Abandoned

Date

JUN 7 1950 19

J. E. TYRA Scout

FORM 252-B
10M 9-49 PETROL

Russell KANSAS

Sec. 5 Twp. 15 R. 12W

Well No. #10 F. Veijl Farm

Shell Company

B & R Drlg. Contractor

Hall-Gurney Pool


330' Ft. from N. Line

Ft. from S. Line

390' Ft. from E. Line

Ft. from W. Line

NE NE NW Twin #1

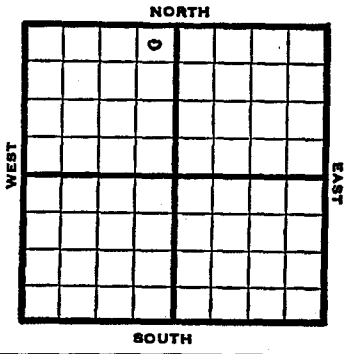

1950	Elev. 1766' REPORT
5/3 6/7	Location 8" @ 698' Lans. 2936' 4" @ 3069' Perf 64/3029-45 " 168/2981-3023 83 BOPD & 23 BWPD COMPLETED

KANSAS Russell

FORM 51 25M 3-49 PETROL

Section 5 Township 15 Range 12-W

Well No. #10 F. Veijl VEJL

Company Shell

