Form 26 200 Bks. 6-49 Petrol
Kansas

Hall-Gurney Pool

Map No. _____ Sec. 5 Twp. 15 R. 12W

Well No. 1 - W Vejl


Shell Company

Herndon Drlg. Contractor

C S L NE NW

FIRST REPORT

SECTION PLAT

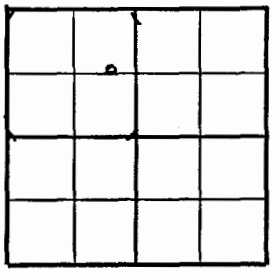

1031 Ft. from N. Line

_____ Ft. from S. Line

666 Ft. from E. Line

_____ Ft. from W. Line

Russell County

Location _____

Rig up _____

Drilling and Remarks:

10" @ 710
drlg. 1350

RECORD

Cased _____ in., _____ ft.

Sand _____

Gas _____

Oil _____

Total Depth _____

PRODUCTION

1st 24 hrs. Nat. _____

1st 24 hrs. after shot _____

Gas _____ Cu. Ft.

Dry Hole _____

Abandoned _____

Date

JUN 29 1949 19

S. J. LEWIS Scout

Form 26 200 Bks. 6-49 Petrol
Kansas

Hall-Gurney Pool

Map No. K55 Sec. 5 Twp. 15 R. 12W

Well No. 1 - W. Vejl


Shell Company

ABANDONED Contractor

E 41764

C S L NE NW

SECTION PLAT

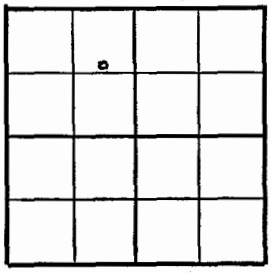

1031 Ft. from N. Line

_____ Ft. from S. Line

666 Ft. from E. Line

_____ Ft. from W. Line

Russell County

Location _____

Rig up _____

Drilling and Remarks:

W. Granite 3178
Granite 3405.

Sand

RECORD

Cased _____ in., _____ ft.

Sand _____

Gas _____

Oil _____

Total Depth 3445

PRODUCTION

1st 24 hrs. Nat. _____

1st 24 hrs. after shot _____

Gas _____ Cu. Ft.

Dry Hole _____

Abandoned _____

Date

JUL 27 1949 19

S. J. LEWIS Scout

FORM 252-A
5M 10-48 PETROL

Russell KANSAS

Sec. 5 Twp. 15 R. 12W

Well No. #1 W Vejl Farm

Shell Company

Hall-Gurney Pool (Herndon Drlg., Cont.)


1031' Ft. from N. Line

Ft. from S. Line

666' Ft. from E. Line

Ft. from W. Line

C S L NE NW

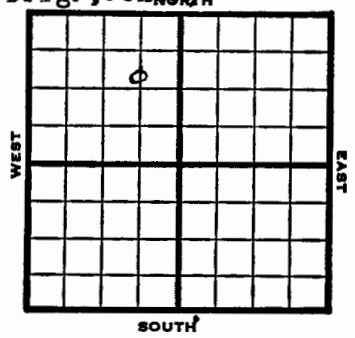

1949	Elv. 1764' REPORT
6/29	10" @ 710' Drlg. 1350'
7/6	Arbuckle 3236' TD 3288' Run 7"
7/12	7"@ 3279' Basal 3293' Granite Wash 3386' Granite 3405' TD 3408'
7/20	"
7/27	W. Granite 3386' Granite 3405' SWD TD 3405' ABANDONED

FORM 51 25M 3-49 PET KANSAS Russell

Section 5 Township 15 Range 12W

Well No. 1-W Vejl

Company She ll

Hall-Gurney Pool

