

Map No. _____ Sec. 5 Twp. 15 R. 12W

Well No. 6 Scharzt

Cities Service Company

FIRST REPORT

Contractor

C N L SW NE

SECTION PLAT

		o	

_____ Ft. from N. Line

990 Ft. from S. Line

_____ Ft. from E. Line

660 Ft. from W. Line

Russell County

Location X

RECORD

Cased _____ in., _____ ft.

Sand _____

Gas _____

Oil _____

Total Depth _____

PRODUCTION

1st 24 hrs. Nat. _____

1st 24 hrs. after shot _____

Gas _____ Cu. Ft.

Dry Hole _____

Abandoned _____

Date

JAN 28 1946 19 S. J. LEWIS Scout

Map No. 55 Sec. 5 Twp. 15 R. 12W

Well No. 6 Scharzt

Cities Service Company

COMPLETE

Contractor

C N L SW NE

E 1134
SECTION PLAT

		o	

_____ Ft. from N. Line

990 Ft. from S. Line

_____ Ft. from E. Line

660 Ft. from W. Line

Russell County

Location _____

RECORD

Cased _____ in., _____ ft.

Sand _____

Gas _____

Oil

Total Depth 8257

PRODUCTION

1st 24 hrs. Nat. _____

1st 24 hrs. after shot _____

Gas _____ Cu. Ft.

Dry Hole _____

Abandoned _____

Date

MAR 10 1948 19 S. J. LEWIS Scout

Drilling and Remarks:
Sorkan 8257
5' @ 8257

Ecler 8257 94

40 Ecler

Russell KANSAS ✓

Sec. 5 Twp. 15 R. 12W

Well No. #6 Schartz Farm _____

Cities Service Company _____

Hall-Gurney


_____ Ft. from N. Line

990 Ft. from S. Line

_____ Ft. from E. Line

660 Ft. from W. Line

C N L SW NE

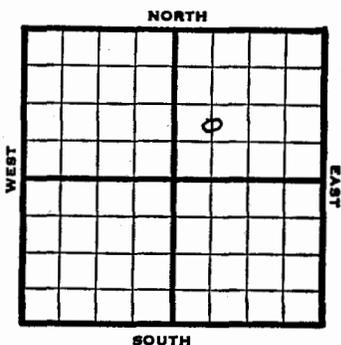


KANSAS

Russell

Section 5 Township 15 Range 12W

Well No. #6 Schartz

Company Cities Service

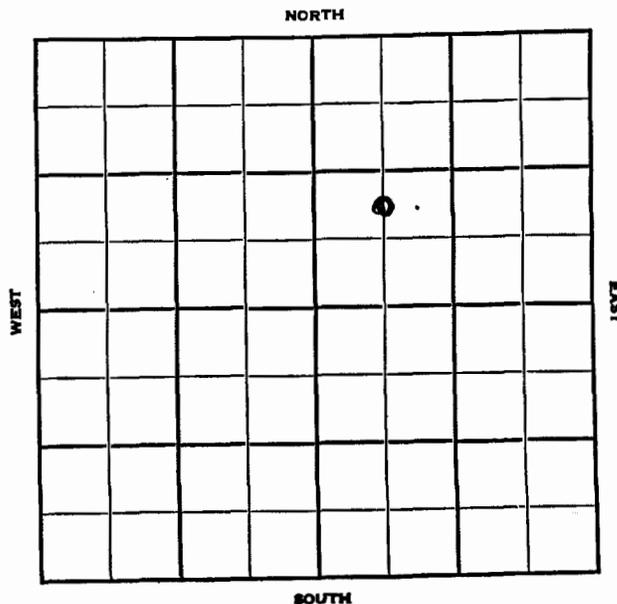

1948 Elev. 1834' REPORT

1/28 Location

2/4 8" @ 522'
Drlg. 1495'

2/11 Drlg. 3169'

2/18 Gorham 3282-83'
TD 3283'
5" @ 3282'
RUST

2/25 Pump 120 bbls oil, 12 hrs.

3/3 "

3/10 Gorham 3282'
5" @ 3282'
Echo Pot 94
Gr. 40.9°
TD 3287'

COMPLETED