

Section 6 Township 15 Range 12W

Well No. #3 S. K. Steinert

Company Texas Co.

County Russell State Kansas

Sec. 6 (Bk. Twp.) 15 (Sur. Rge.) 12W Map No.

Operator Texas Co.

Well No. 3 Farm S. K. Steinert

Elev. Location C N/2 NE NW


330 Ft. From N Line NW

660 Ft. From E Line Quarter

1st. Report AUG 6 1952

Completion

Remarks


Stackle - Contr.

Spudding Date 8-4-52

Drig. Data

Eng. surf.

J. G. McGEHEE

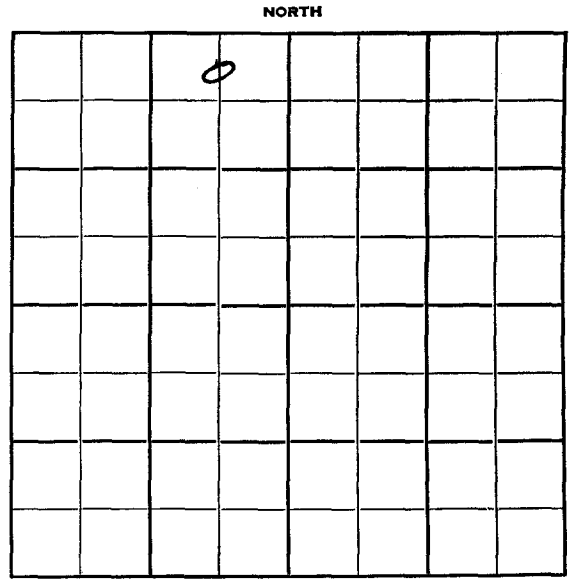



Russell KANSAS ✓

Sec. 6 Twp. 15 R. 12 W

Well No. # 3 S. K. Steinert Farm

Texas Co. Company

Steckle Contractor


330 Ft. from N. Line

\_\_\_\_\_ Ft. from S. Line

660 Ft. from E. Line

\_\_\_\_\_ Ft. from W. Line

C N/2 NE NW

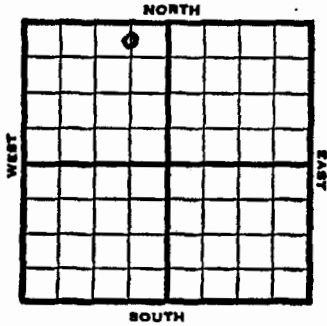

1952	Elev. 1734'	REPORT
8/6		Spud 8-4-52 Rng. surf.
8/13		8" @ 692' f 2180-2228 48' f
8/20		Langdon 2255' Tarkio 2316' Br li 3000'
8/27		DST 3120-40 1 hr. 25' M DST 3161-80 2 hrs. 20' M Arb. 3197 DST 3198-3202 1 hr. 225' SW 985# RTD 3202 5" @ 3050
9/3		CO 3014 40/300-3010 2 galwph 500 A S/17 galo & 5 galwph PB 2992 10-/2974-77 7/Bswph set plug 2960 22/2928-35 S/ 3 Boph 500 A no help 2500 A
9/10		35 gal O plus 10 gal WPH PB 2920' 16/2910-15 14 BO plus 1/4 BWPH 500 A 4 1/2 BO plus 3/4 BWPH CO 2960'
9/17		P/14 BO plus 10 BW 8 hrs.
9/24		P/41 BOPD P/38 90 plus 16 BWPD

OVER

1952  
10/1

Spud 8-4-52  
Oil well TD 3014' 8" @ 692  
Langdon 2255' Tarkio 2316'  
DST 2911-20 open 1/2 hr. rec 15' mud  
180#  
DST 2929-45, open 1 hr. rec 30' mud  
60#  
DST 2970-95 open 1 hr. rec 120' HO  
& GCM, 300' SW 470#  
Br. lime 3000'  
DST 3102-20 open 1 hr. rec 15' St CM  
40#  
DST 3120-40 open 1 hr. rec 25' mud O#  
DST 3161-80 open 2 hr, rec 20' mud O#  
Arb. 3197'  
DST 3198-3202' open 1 hr. rec 225' SW  
985# TD 3202' 5" @ 3050  
CO to 3014 40/3000-10 2 GWPH  
500 A S/17 GO 5 GWPH PB 2992  
10/2974-77 7 BSWPH SP 2960  
22/2928-35 S/3 BOPH 500 A  
no help 2500 A 35 GO 10 GWPH  
PB 2920 16/2910-15 1/4 BO 1/4 BWPH  
500 A 4 1/2 BO 3/4 BWPH CO to 2960  
P/14 BO 10 BW 8 hr. P/41 BOPD  
P/38 BO 16 BWPD  
Comp. 32 BOPD 14 BW

COMPLETED