

Pool Name Hall-GurneyMap No. 55 Sec. 6 Twp. 15 R. 12WWell No. 1 S. K. SteinertTexas

Company _____

FIRST REPORT

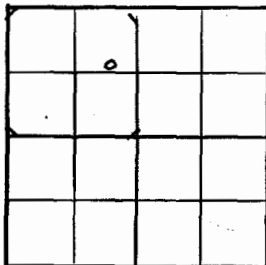
Contractor _____

C S L NE NW**SECTION PLAT**990 Ft. from N. Line

_____ Ft. from S. Line

660 Ft. from E. Line

_____ Ft. from W. Line

Russell County

Location _____

Rig up _____

Drilling and Remarks:

Cellar**RECORD**

Cased _____ in., _____ ft.

Sand _____

Gas _____

Oil _____

Total Depth _____

PRODUCTION

1st 24 hrs. Nat. _____

1st 24 hrs. after shot _____

Gas _____ Cu. Ft.

Dry Hole _____

Abandoned _____

Date

JUL 19 1944

19

S. J. LEWIS

Scout

Pool Name Hall-Gurney PoolMap No. 55 Sec. 6 Twp. 15 R. 12WWell No. 1 S. K. SteinertTexas

Company _____

COMPLETED

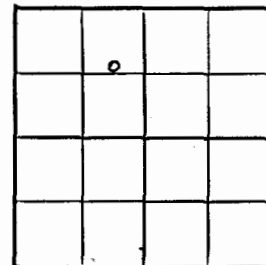
Contractor _____

C S L NE NW**SECTION PLAT**990 Ft. from N. Line

_____ Ft. from S. Line

660 Ft. from E. Line

_____ Ft. from W. Line

Russell County

Location _____

Rig up _____

Drilling and Remarks:

Cell 43176
5'08 1/2"Pump 135 in 6790 Water
Box.38 1/2"**RECORD**

Cased _____ in., _____ ft.

Sand _____

Gas _____

Oil _____

Total Depth 9125**PRODUCTION**

1st 24 hrs. Nat. _____

1st 24 hrs. after shot _____

Gas _____ Cu. Ft.

Dry Hole _____

Abandoned _____

Date

SEP 27 1944

19

S. J. LEWIS

Scout

KANSAS

Russell

Sec. 6 Twp. 15 R. 12W

Well No. #1 S K Steinert Farm
Texas Company Company

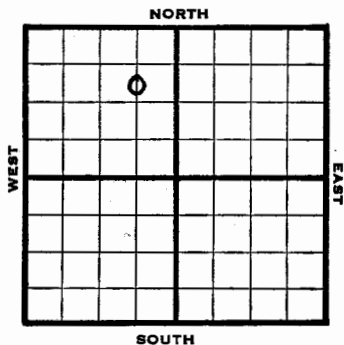
Hall-Gurney

990 Ft. from N. Line

_____ Ft. from S. Line

660 Ft. from E. Line

_____ Ft. from W. Line



Elev. 1743

1944 REPORT

7/19 Cellar
7/26 Drlg. 290'
8/2 Anhy 694 8" @ 702 Drlg. 2100
8/9 Arb. 3196 TD 8201 Satt/
8/16 5" @ 3195 $\frac{1}{2}$ swb 80 oil plus 16 wtr in
2 $\frac{1}{2}$ hrs. PB 3197 WOC
8/23 PB 313144 WOC
8/30 TD 3198
Pump 378 oil plus 40 wtr in 24 hrs.
9/8 " " " " " " " " " "
9/13 " " " " " " " " " "
9/21 " " " " " " " " " "
9/27 Arb 3196
5" @ 3195 $\frac{1}{2}$
Pump 135 oil plus 90 wtr. pot.
Grav. 38.5
TD 3198

COMPLETED

KANSAS

Russell

Section 6 Township 15 Range 12W

Well No. #1 S K Steinert

Company Texas

