

Map No. 55 Sec. 6 Twp. 15 R. 12WWell No. 1 Hupfer

Black-Marshall Company

FIRST REPORT

Contractor

NE SE

SECTION PLAT330 Ft. from N. Line

Ft. from S. Line

330 Ft. from E. Line

Ft. from W. Line

Russell County

Location

Rig up

Drilling and Remarks:

8" @ 280

drlg. 835

RECORD

Cased in, ft.

Sand

Gas

Oil

Total Depth

PRODUCTION

1st 24 hrs. Nat.

1st 24 hrs. after shot

Gas Cu. Ft.

Dry Hole

Abandoned

Date

JAN 2 1947 19

S. J. LEWIS

Scout

Map No. 55 Sec. 6 Twp. 15 R. 12WWell No. 1 Hupfer

Black-Marshall Company

COMPLETE

Contractor

NE SE

SECTION PLAT330 Ft. from N. Line

Ft. from S. Line

330 Ft. from E. Line

Ft. from W. Line

Russell County

Location

Rig up

Drilling and Remarks:

*cut 3281**5" @ 3282**Pump 20 oil + 14**P.S.**39 3/4***RECORD**

Cased in, ft.

Sand

Gas

Oil

Total Depth *3282***PRODUCTION**

1st 24 hrs. Nat.

1st 24 hrs. after shot

Gas Cu. Ft.

Dry Hole

Abandoned

Date

FEB 5 1947 19

S. J. LEWIS

Scout

Russell County

Sec. 6 Twp. 15 R. 12W

Well No. 1 Hupfer Farm
Black-Marshall Company


Hall-Gurney

330 Ft. from N. Line

Ft. from S. Line

330 Ft. from E. Line

Ft. from W. Line

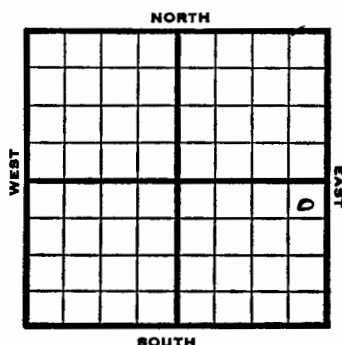

NE SE

1947 Elev. 1829 REPORT

1/2 8" @ 280'
Drlg 835'
1/8 Drlg 2740'

1/15 Lans 2982
Arb 3281
TD 3284'
5" @ 3282
RUST

1/21 Pump 6 oil & 15 W PH 6 hrs
PB

2/5 TD 3284'
Arb 3281
5" @ 3282
Pump 25 oil & W Pot
39 Grav.

COMPLETED

Russell county

Section 6 Township 15 Range 12-W

Well No. #1, Hupfer

Company Black-Marshall

