

Russell KANSAS

SEC. 7 TWP. 15 R. 12W

WELL NO. 1 Major FARM

COMPANY Sterling Drlg. & Durbin-Bond

CONTRACTOR Group Explor.


Hall-Gurney Ext. 990 Ft. from N. Line

Ft. from S. Line

330 Ft. from E. Line

Ft. from W. Line

SE NE NE

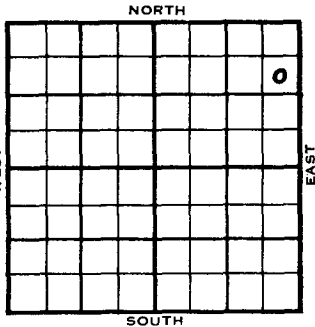

	ELEVATION	REPORT
1953	1830'	

12/16 Spud 12-14-53
8" @ 480', WOC

12/30 Spud 12-14-53
D & A

TD 3311'
8" @ 480'

Heeb 2913', Tor 2931', Br. Lime 2998'

Lans 3012', Cong 3289' Arb 3306'

TD 3311'
D & A

ABANDONED

Russell

KANSAS

FORM 51

Section 7 Township 15 Range 12W

Well No. #1 Major

Company Sterling Drlg. & Durbin-Bond

