

Pool Name Hall-Gurney

Map No. 55 Sec. 7 Twp. 15 R. 12W


Well No. 1 Hupfer

Premier Drlg. Company

FIRST REPORT Contractor

SE NW

SECTION PLAT

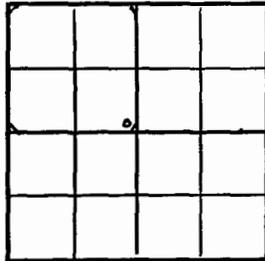

Ft. from N. Line

330 Ft. from S. Line

330 Ft. from E. Line

Ft. from W. Line

Rus sell

Location X

Rig up

Drilling and Remarks:

RECORD

Cased _____ in., _____ ft.

Sand _____

Gas _____

Oil _____

Total Depth _____

PRODUCTION

1st 24 hrs. Nat. _____

1st 24 hrs. after shot _____

Gas _____ Cu. Ft.

Dry Hole _____

Abandoned _____

Date

JAN 10 1945 19 S. J. LEWIS Scout

Pool Name Hall-Gurney

Map No. K55 Sec. 7 Twp. 15 R. 12W


Well No. 1 Hupfer

Premier Drlg. Company

ABANDONED Contractor

SE NW

SECTION PLAT

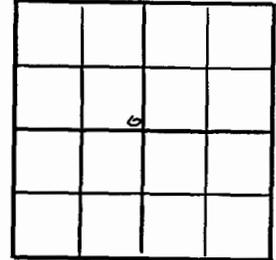

Ft. from N. Line

330 Ft. from S. Line

330 Ft. from E. Line

Ft. from W. Line

Russell

Location _____

Rig up

Drilling and Remarks:

Lease 2992

Oil 3279

RECORD

Cased _____ in., _____ ft.

Sand _____

Gas _____

Oil _____

Total Depth 3300

PRODUCTION

1st 24 hrs. Nat. _____

1st 24 hrs. after shot _____

Gas _____ Cu. Ft.

Dry Hole _____

Abandoned _____

Date

FEB 7 1945 19 S. J. LEWIS Scout

KANSAS

Sec. 7 Twp. 15S R. 12W

Well No. #1, Hupfer Farm _____

Premier Drilling Company


Hall-Gurney

_____ Ft. from N. Line

330 Ft. from S. Line

330 Ft. from E. Line

_____ Ft. from W. Line

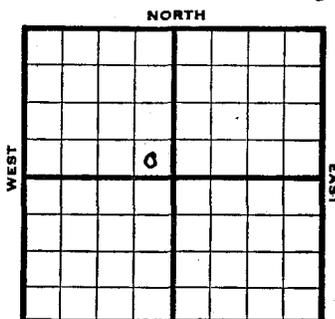

SE NW Elev. 1811

1945 R E P O R T

1-10	Location	
1/17	Drlg 290	
1/26	Drlg. 1565	
	10" @ 300	
1/31	Drlg. 2920'	
2/7	Lans	2992
	Arb.	3279
	TD 3300'	

ABANDONED

KANSAS

Section 7 Township 15 Range 12W

Well No. #1 Hupfer

Company Premier Drlg

