

Map No. _____ Sec. 7 Twp. 15 R. 12W

Well No. 1 Parker

Lindas Drlg. Company

FIRST REPORT

Contractor

SW/C

SECTION PLAT

_____ Ft. from N. Line

330 Ft. from S. Line

_____ Ft. from E. Line

330 Ft. from W. Line

Russell County

Location X

RECORD

Cased _____ in., _____ ft.

Sand _____

Gas _____

Oil _____

Total Depth _____

PRODUCTION

1st 24 hrs. Nat. _____

1st 24 hrs. after shot _____

Gas _____ Cu. Ft.

Dry Hole _____

Abandoned _____

Date

APR 6 1949

S. J. LEWIS Scout

Map No. K55 Sec. 7 Twp. 15 R. 12W

Well No. 1 Parker

Lindas Drlg. Company

COMPLETE

Contractor

SW/C

SECTION PLAT

_____ Ft. from N. Line

330 Ft. from S. Line

_____ Ft. from E. Line

330 Ft. from W. Line

Russell County

Location _____

RECORD

Cased _____ in., _____ ft.

Sand _____

Gas _____

Oil _____

Total Depth 2308

PRODUCTION

1st 24 hrs. Nat. _____

1st 24 hrs. after shot _____

Gas _____ Cu. Ft.

Dry Hole _____

Abandoned _____

Date

JUN 22 1949

S. J. LEWIS Scout

Liana 3016

Fr 1300

5" @ 3302

Prof Lane

3000 and


Prod 8330 oil + 20%

Prod

36-34

O. W. P. B. KANSAS Russell
 Sec. 7 Twp. 15 R. 12W ✓
 Well No. #1 Parker Farm
Lindas Drlg. Company

Hall-Gurney
 _____ Ft. from N. Line
330' Ft. from S. Line
 _____ Ft. from E. Line
330' Ft. from W. Line

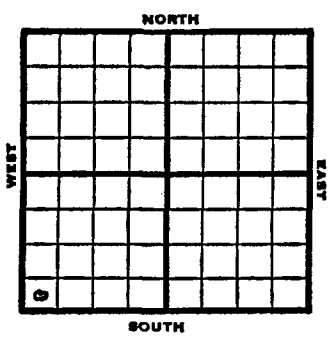

SW/C

1949	Elev. 1856'	REPORT
4/6		Location
4/12		"
4/20		RUR
4/27		8" @ 378' Drlg 2356'
5/3		Arb. 3300' TD 3308 5" @ 3302'
5/10		54 shots 3086-3102 300 oil 2½ hrs. 1000 acid Flow 210 bbls oil in tank Flow oil in pits in 13 mint.
5/18		2000 acid Flow 21 bbls oil PH 8 hrs.
5/25		"
6/1		"
6/7		"
6/15		"
6/22		Lans. 3016' Arb 3300' 5" @ 3302' Perf Lans. 3000 acid Pump 833 oil & 20% W Pot. Gr. 36° TD 3308'

COMPLETED

OVER

1951
 4/18
O. W. P. B.
 Toronto 2954'
 Lansing 3016'
 Arbuckle 3300'
 5" @ 3302' PB 3050'
 2 1/4 / 2963-57 2 1/4 / 2946-52 SSO
 250 A S/4 BOPH 3 hr.
 3500 A S/1 1/2 BOPH
 Testing

5/2
 Oil well TD 3070'
 Tor. 2954' Lans 3016' Arb. 3300'
 5" @ 3302' PB 3050' 2 1/4 / 2963-57'
 2 1/4 / 2946-52 SSO 250 A S/4 BOPH
 3 hr. 3500 A S/1 1/2 BOPH
 PB 3094' S/5 BFPH 50% water
 S/2 1/4 BFPH 20% oil Perf. 3051-57
 S/ 15 BFPH SP 3070' 4750 A
 S/ 5 BOPH
 Comp. 40 BOPD

COMPLETED

O. W. P. B.
FORM 57 FORM 2-59 PETROL

KANSAS Russell

Section 7 Township 15 Range 12W

Well No. 1 Parker

Company Lindas Drlg.
Hall-Gurney

