

KANSAS Russell
Map No. 55 Sec. 7 Twp. 15 R. 12W

Well No. 1 Parker

Harry Gore

Company

FIRST REPORT

Contractor


SE SW

SECTION PLAT

_____ Ft. from N. Line

330 Ft. from S. Line330 Ft. from E. Line

_____ Ft. from W. Line

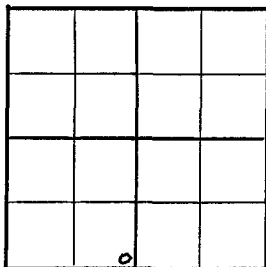

GUSTASON POOL

Location XXX

Rig up _____

Drilling and Remarks:

RECORD

Cased _____ in., _____ ft.

Sand _____

Gas _____

Oil _____

Total Depth _____

PRODUCTION

1st 24 hrs. Nat. _____

1st 24 hrs. after shot _____

Gas _____ Cu. Ft.

Dry Hole _____

Abandoned _____

Date

MAR 17 1943

19

S. J. LEWIS

Scout

KANSAS Russell
Map No. 55 Sec. 7 Twp. 15 R. 12W

Well No. 1 Parker

Harry Gore

Company

ABANDONED

Contractor


SE SW

SECTION PLAT

_____ Ft. from N. Line

330 Ft. from S. Line330 Ft. from E. Line

_____ Ft. from W. Line

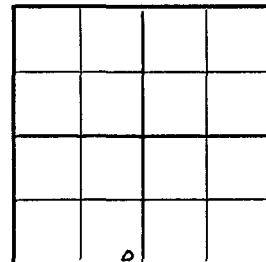

GUSTASON POOL

Location _____

Rig up _____

Drilling and Remarks:

Oil 3274Water.

RECORD

Cased _____ in., _____ ft.

Sand _____

Gas _____

Oil _____

Total Depth 3285

PRODUCTION

1st 24 hrs. Nat. _____

1st 24 hrs. after shot _____

Gas _____ Cu. Ft.

Dry Hole _____

Abandoned _____

Date

JUN 2 1943

19

S. J. LEWIS

Scout

KANSAS

Russell


Sec. 7 Twp. 15 R. 12-WWell No. #1 Parker FarmHarry Gore Company

Gustason

Ft. from N. Line

330 Ft. from S. Line330 Ft. from E. Line

Ft. from W. Line

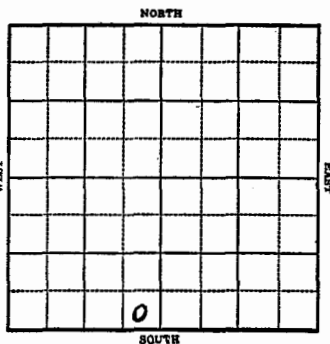lev. 1828

1943

REPORT

3/17 Location.

3/24 "

3/31 "

4/7 "

4/14 Derrick

4/21 "

4/28 Drlg. 465 no csg in hole.

5/5 12" @ 500'

Anhy 768'

10" @ 775'

Drlg. 1775'

5/12 Drlg. 2245'

5/19 8" @ 2500

Topeka 2645

Drlg. 2765

5/26 Lens 2999

7" @ 3031

Drlg. 3076'

6/2 Arb. 3274

T.D. 3295'

Water

ABANDONED

KANSAS

Russell

FORM 51 5M 1-42 PETROL

Section 7 Township 15 Range 12-WWell No. #1 ParkerCompany Harry Gore