

KANSAS Kansas Pool Name Hall-Gurney  
 Map No. 35 Sec. 8 Twp. 15 R. 12W  
 Well No. 1 Washburn  
Phil-Han and Gore Company  
**FIRST REPORT** Contractor

SW NW

## SECTION PLAT

|   |  |  |  |
|---|--|--|--|
|   |  |  |  |
|   |  |  |  |
| 0 |  |  |  |
|   |  |  |  |

\_\_\_\_\_ Ft. from N. Line  
330 Ft. from S. Line  
 \_\_\_\_\_ Ft. from E. Line  
330 Ft. from W. Line

Russell County

Location X  
 Rig up \_\_\_\_\_  
 Drilling and Remarks:

**RECORD**  
 Cased \_\_\_\_\_ in., \_\_\_\_\_ ft.  
 Sand \_\_\_\_\_  
 Gas \_\_\_\_\_  
 Oil \_\_\_\_\_  
 Total Depth \_\_\_\_\_

**PRODUCTION**  
 1st 24 hrs. Nat. \_\_\_\_\_  
 1st 24 hrs. after shot \_\_\_\_\_  
 Gas \_\_\_\_\_ Cu. Ft.  
 Dry Hole \_\_\_\_\_  
 Abandoned \_\_\_\_\_

Date

JAN 23 1946 19 S. J. LEWIS Scout

KANSAS Kansas Pool Name Hall-Gurney  
 Map No. 55 Sec. 8 Twp. 15 R. 12W  
 Well No. 1 Washburn  
Phil Han and Gore Company  
**ABANDONED** Contractor

SW NW

E1,1846  
SECTION PLAT

|   |  |  |  |
|---|--|--|--|
|   |  |  |  |
|   |  |  |  |
| 0 |  |  |  |
|   |  |  |  |

\_\_\_\_\_ Ft. from N. Line  
330 Ft. from S. Line  
 \_\_\_\_\_ Ft. from E. Line  
330 Ft. from W. Line

Russell County

Location \_\_\_\_\_  
 Rig up \_\_\_\_\_  
 Drilling and Remarks:

At 8298'  
have 300'

**RECORD**  
 Cased \_\_\_\_\_ in., \_\_\_\_\_ ft.  
 Sand \_\_\_\_\_  
 Gas \_\_\_\_\_  
 Oil \_\_\_\_\_  
 Total Depth 8280

**PRODUCTION**  
 1st 24 hrs. Nat. \_\_\_\_\_  
 1st 24 hrs. after shot \_\_\_\_\_  
 Gas \_\_\_\_\_ Cu. Ft.  
 Dry Hole \_\_\_\_\_  
 Abandoned \_\_\_\_\_

Date

FEB 6 1946 19 S. J. LEWIS Scout

KANSAS

Russell County

Sec. 8 Twp. 15 R. 12W

Well No. #1 Washburn Farm

Phil-Han and Gore Company

Hall-Gurney


Ft. from N. Line

330 Ft. from S. Line

Ft. from E. Line

330 Ft. from W. Line

SW NW

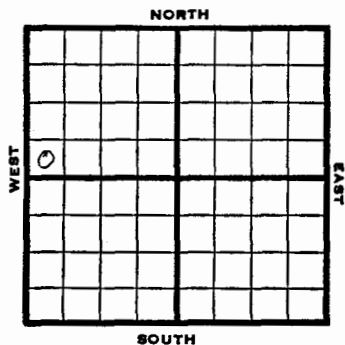

1946 Elev. 1846' REPORT

1/23 Location  
1/31 8" - 806' Anhy 780'  
Drlg. 2920'

2/6 Arb. 3298  
Lens 3007  
TD 3330'

ABANDONED

KANSAS

Russell

Section 8 Township 15 Range 12W

Well No. #1 Washburn

Company Phil-Han & Gore

