

Russell KANSAS

Sec. 8 Twp. 15 R. 12 W

Well No. # 3 Dawson Farm

Murfin Drlg. Company

Murfin Drlg. Contractor


990 Ft. from N. Line

Ft. from S. Line

1320 Ft. from E. Line

Ft. from W. Line

C S L N/2 SE

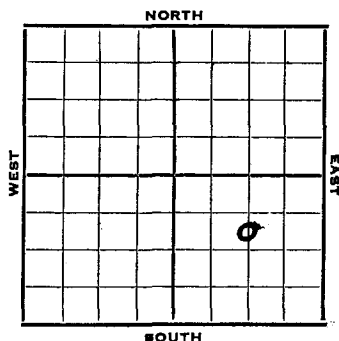

1952 Elev. 1810' REPORT

10/15 Spud 10-9-52
Drlg. 1875'

10/22 Spud 10-9-52
D&A
TD 3295'
8" @ 260'
Heeb. 2877', Br. Lime 2962', Lans
2973, B KC 3251', Cong. 3255', Arb.
3274'
TD 3295
D&A

ABANDONED

Section 8 Township 15 Range 12W

Well No. #3 Dawson

Company Murfin Drlg.

