

Map No. 55 Sec. 9 Twp. 15 R. 12W

Well No. 1 Zeman

Threeway Drlg. Company

FIRST REPORT Contractor

NW SW

SECTION PLAT

330 Ft. from N. Line

_____ Ft. from S. Line

_____ Ft. from E. Line

330 Ft. from W. Line

Russell County

Location _____

Rig up _____

Drilling and Remarks:

10" @ 235

Anhy 750

drlg. 1570

RECORD

Cased _____ in., _____ ft.

Sand _____

Gas _____

Oil _____

Total Depth _____

PRODUCTION

1st 24 hrs. Nat. _____

1st 24 hrs. after shot _____

Gas _____ Cu. Ft.

Dry Hole _____

Abandoned _____

Date

APR 30 1947 19

S. J. LEWIS Scout

Map No. 55 Sec. 9 Twp. 15 R. 12W

Well No. 1 Zeman

Threeway Drlg. Company

COMPLETE Contractor

NW SW

SECTION PLAT

330 Ft. from N. Line

_____ Ft. from S. Line

_____ Ft. from E. Line

330 Ft. from W. Line

Russell County

Location _____

Rig up _____

Drilling and Remarks:

Lease 2990

2' @ 3045

1000 acid

Pump 75 BT

40' @

RECORD

Cased _____ in., _____ ft.

Sand _____

Gas _____

Oil _____

Total Depth 3265

PRODUCTION

1st 24 hrs. Nat. _____

1st 24 hrs. after shot _____

Gas _____ Cu. Ft.

Dry Hole _____

Abandoned _____

Date

JUL 30 1947 19

S. J. LEWIS Scout

Sec. 9 Twp. 15 R. 12-W **Russell** ✓

Well No. #1 Zeman Farm

Murfin Drlg
Threeway Drlg


Hall-Gurney Pool **O. W. D. D** Company

330 Ft. from N. Line

_____ Ft. from S. Line

_____ Ft. from E. Line

330 Ft. from W. Line

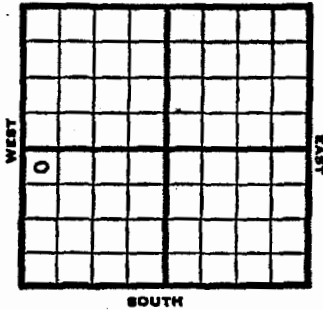

NW SW

REPORT

1947	Elev. 1827'
4/30	10" @ 235' Anhy 750' Drlg 1570'
5/7	Drlg 2925'
5/13	TD 3047' 7" @ 3045' RUsT
5/20	Lans 2990' TD 3047' SO
5/27	TD 3065' 1000 Acid Swb. 2 bbls. oil PH 16 hrs.
6/3	" " " "
6/10	" " " "
6/17	" " " "
6/24	" " " "
7/1	" " " "
7/8	" " " "
OVER	

7-16 TD 3065

7/22 "

7/30 Lans. 2990'
7" @ 3045'
1000 Acid
Pump 75 Pot
40.0 Gr.
TD 3065'

COMPLETED

1951

O. W. D. D

5/23 Lans. 2990 OTD 3065
7" @ 3045 DD 3297
Set 205' of 5" liner @ 3297
Drlg. 3330'

5/29 SWD Well TD 3350
Lans. 2990 OTD 3065 7" @ 3045
DD 3297 BKC 3230
Cong. 3266 Sand 3289
DST 3291-3328 opn 1 hr
Rec. 2350' wtr 5" @ 3297
TD 3350 Comp. for SWD well

ABANDONED

Russell,

FORM 51 10M 12-46 PETROL


O. W. D. D KANSAS

Section 9 Township 15 Range 12W

Well No. 1 Zeman

Company Murfin Drilo
Threeway Drilg.

Hall-Gurney NORTH

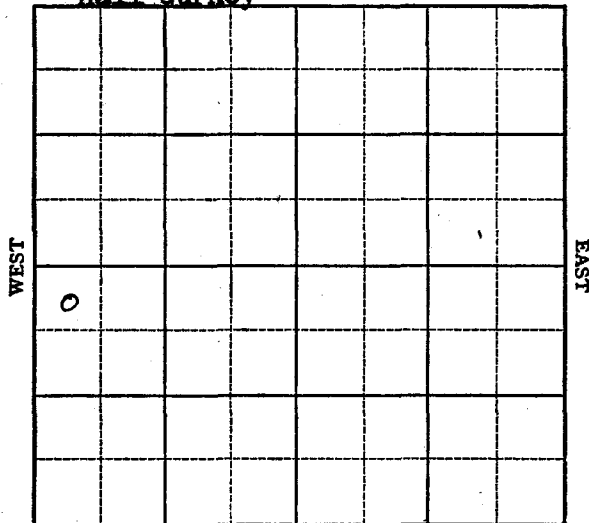

SOUTH