

KANSAS

Kansas Pool Name Hall-Gurney

Map No. 55 Sec. 19 Twp. 15 R. 12W

Well No. 1 Zeman

Black-Marshall Company

FIRST REPORT

Contractor

SE NE

SECTION PLAT

_____ Ft. from N. Line

330 Ft. from S. Line

330 Ft. from E. Line

_____ Ft. from W. Line

Russell County

Location X

Rig up _____

Drilling and Remarks:

RECORD

Cased _____ in., _____ ft.

Sand _____

Gas _____

Oil _____

Total Depth _____

PRODUCTION

1st 24 hrs. Nat. _____

1st 24 hrs. after shot _____

Gas _____ Cu. Ft.

Dry Hole _____

Abandoned _____

Date

OCT 2 1946 19

S. J. LEWIS Scout

KANSAS Hall-Gurney Pool

Form 26 200 Bks. 10-46 Petrol
Kansas

Map No. 55 Sec. 9 Twp. 15 R. 12W

Well No. 1 Zeman

Black-Marshall Company

CORRECTION

Contractor

SE NE

SECTION PLAT

_____ Ft. from N. Line

330 Ft. from S. Line

330 Ft. from E. Line

_____ Ft. from W. Line

Russell County

Location _____

Rig up _____

Drilling and Remarks:

Reported in

19-15-12W

RECORD

Cased _____ in., _____ ft.

Sand _____

Gas _____

Oil _____

Total Depth _____

PRODUCTION

1st 24 hrs. Nat. _____

1st 24 hrs. after shot _____

Gas _____ Cu. Ft.

Dry Hole _____

Abandoned _____

Date

OCT 9 1946 19

S. J. LEWIS Scout

Sec. ~~19~~ 9 Twp. 15 R. 12-W

Map No. _____ Sec. 9 Twp. 15 R. 12W

Well No. 1 Zeman

Well No. #1, Zeman Farm

Black-Marshall Company

Black-Marshall Company

ABANDONED

Hall-Gurney

Contractor


Ft. from N. Line

SE NE

E1, 1833

SECTION PLAT

_____ Ft. from N. Line

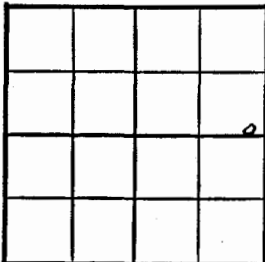

330 Ft. from S. Line

330' Ft. from S. Line


330 Ft. from E. Line

330' Ft. from E. Line

_____ Ft. from W. Line

_____ Ft. from W. Line

SE NE

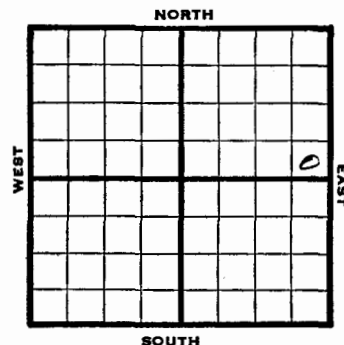

Russell County

REPORT

Location _____

RECORD

Rig up _____

Cased _____ in., _____ ft.

Drilling and Remarks:

Sand _____

Gas _____

Oil _____

Total Depth *3292*

PRODUCTION

1st 24 hrs. Nat. _____

1st 24 hrs. after shot _____

Gas _____ Cu. Ft.

Dry Hole _____

Abandoned _____

Date

JAN 8 1947 19 S. J. LEWIS Scout

1946 Elev. 1833'

10/2 Location

10/8 "

10/15 "

10/22 "

10/29 "

11/6 "

11/12 "

11/20 "

11/27 15" @ 450'
Drlg 550'

12/3 Anhy 735'
10" @ 740'
Drlg 1625'

12/10 Drlg 2360'

12/17 2395 UR 8"

1947

1/4 Lans 2988'
7" @ 2990'
Drlg 3240'

1/8 Arb 3280'
TD 3292'

ABANDONED

Russell county

Section 9 Township 15 Range 12-W

Well No. #1, Zeman

Company Black-Marshall

