

Drig. Data Gustason
8" @ 288 Drig. 2845

Drlg. Data	D & A	TD 3221
8" @ 238	Arb. 3213	DST 3212-15
Rec. 10' ocm	DST 3219	Rec. 19' mcm
5" @ 3214	TD 3221	S/ 1 $\frac{1}{2}$ bwph & SSO
PB 3217	8/ in open hole	
	D & A	

J. E. TYRA

Russell

KANSAS

Sec. 10 Twp. 15 R. 12W

Well No. #1 Kaufman ☒ Farm

Lindsley Drlg. et al Company

Gustason Contractor


Ft. from N. Line

330' Ft. from S. Line

990' Ft. from E. Line

Ft. from W. Line

SW SE SW

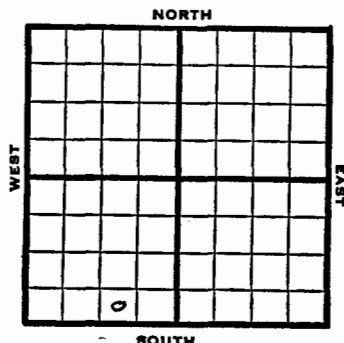


KANSAS

Section 10 Township 15 Range 12W

Well No. #1 Kaufman

Company Lindsley Drlg. et al

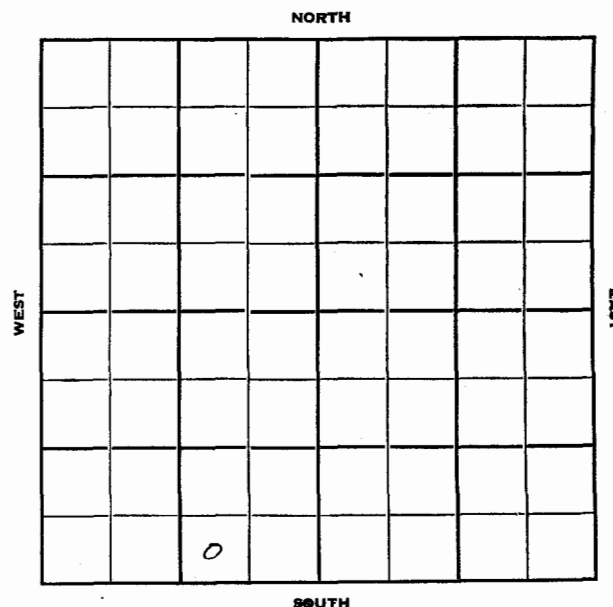

1951	Elev. 1785'	REPORT
10/17	Spud 10-8-51 8" @ 238 Drlg. 2845'	
11/14	Spud 10-8-51 D & A TD 3221' 8" @ 238' Arb. 3213' DST 3212-15 rec 10' OCM DST 3219' rec 19' OCM 5" @ 3214' TD 3221' S/1½ BWPH & SSO PB 3217' 8/in open hole D & A	
ABANDONED		