


County **Russell** State **Kansas**
 Sec. **13** (Blk. Twp.) **15** (Sur. Rge.) **12W** Map No.
 Operator **Anschutz Drlg.**
 Well No. **1** Farm **Shaffer**
 Elev. Location **S7 SW NE**

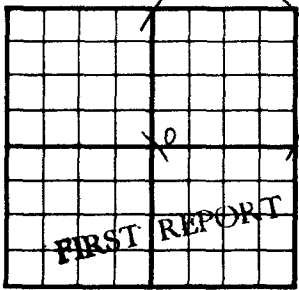


330 Ft. From **S** Line **NE**
330 Ft. From **W** Line Quarter
 1st. Report **JUL 30 1952**
 Completion
 Remarks
Flourney - Contr.
 Spudding Date **7-28-52**

Drlg. Data
8" @ 214 drlg. 500

J. G. McGEHEE

County **Russell** State **Kansas**
 Sec. **13** (Blk. Twp.) **15** (Sur. Rge.) **12W** Map No.
 Operator **Anschutz Drlg.**
 Well No. **1** Farm **Shaffer**
 Elev. **1869** Location **SW SW NE**

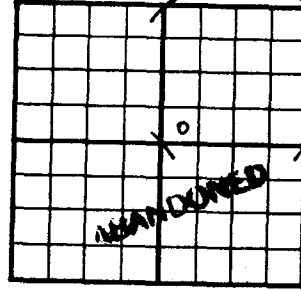

330 Ft. From **S** Line **NE**
330 Ft. From **W** Line Quarter
 1st. Report
 Completion **AUG 13 1952**
 Remarks
Flourney - Contr.
 Spudding Date **7-28-52**

Drlg. Data **D & A TD 3355**
8" @ 214 Heeb. 2937 Lans. 3028
Cong. 3328 Arb. 3352 TD 3355
D & A

J. G. McGEHEE

Sec. 13 Twp. 15 R. 12W

Well No. #1 Shaffer Farm

Anschutz Drlg. Company

Flourney Contractor

Ft. from N. Line

330


Ft. from S. Line

Ft. from E. Line

330

Ft. from W. Line

SW SW NE

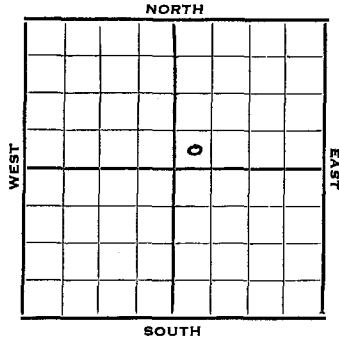

1952 Elev. 1869' REPORT

7/30 Spud 7-28-52
8" @ 214'
Drlg. 500'

8/6 Heeb 2937 Lans. 3028
Drlg. 3220'

8/13 Spud 7-28-52
D&A TD 3355' 8" @ 214'
Heeb. 2937 Lans. 3028
Cong. 3328 Arb. 3352
TD 3355' D&A

ABANDONED

Section 13 Township 15 Range 12 W

Well No. # 1 Shaffer

Company Anschutz Drlg.

