

Map No. _____ Sec. 14 Twp. 15 R. 12W

Well No. 1 Kaufman

Plains Exploration Company

FIRST REPORT Contractor

SE NW SE


SECTION PLAT

990 Ft. from N. Line

Ft. from S. Line

Ft. from E. Line

990 Ft. from W. Line

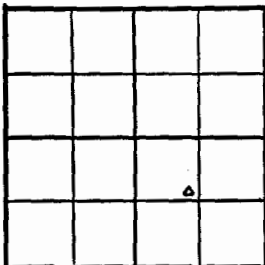

Russell County

Location _____

Rig up _____

Drilling and Remarks:

drlg. 500

RECORD

Cased _____ in., _____ ft.

Sand _____

Gas _____

Oil _____

Total Depth _____

PRODUCTION

1st 24 hrs. Nat. _____

1st 24 hrs. after shot _____

Gas _____ Cu. Ft.

Dry Hole _____

Abandoned _____

Date

DEC 22 1948

19

S. J. LEWIS

Scout

Map No. 55 Sec. 14 Twp. 15 R. 12W

Well No. 1 Kaufman

Plains Exploration Company

COMPLETE

Contractor

SE NW SE


SECTION PLAT

990 Ft. from N. Line

Ft. from S. Line

Ft. from E. Line

990 Ft. from W. Line

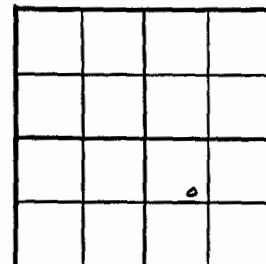

Russell County

Location _____

Rig up _____

Drilling and Remarks:

Liam 2527

7°C 2980

10000 cu. ft.

Pump Oil 1000

RECORD

Cased _____ in., _____ ft.

Sand _____

Gas _____

Oil _____

Total Depth 2631

PRODUCTION

1st 24 hrs. Nat. _____

1st 24 hrs. after shot _____

Gas _____ Cu. Ft.

Dry Hole _____

Abandoned _____

Date

MAR 9 1949

19

S. J. LEWIS

Scout

KANSAS Russell

Sec. 14 Twp. 15 R. 12-W ✓

Well No. #1 Kaufman Farm

Plains Exploration Company

Hall-Gurney


990 Ft. from N. Line

_____ Ft. from S. Line

_____ Ft. from E. Line

990 Ft. from W. Line

SE NW SE

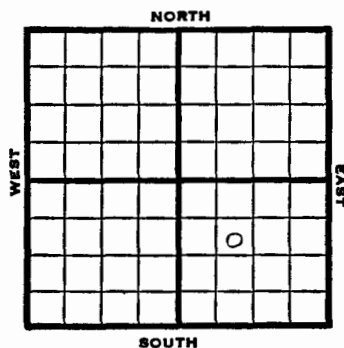

1948 Elev 1805' REPORT

12/22 Drlg 500
12/29 15" @ 250'
13" @ 443
10" @ 700'
Drlg 708'
1/5 Drlg. 1480'
1/12 Drlg 2030 ?
1/19 8" @ 2047'
Drlg 2425'
1/26 Drlg 2780'
2/2 Drlg. 2780'
2/9 Topeka 2655'
Lansing 2927-2865'
2/16 ~~Rum 5"~~
7" @ 2980'
TD 3031'
1000 Oil
2/23 TD 3031'
1000 acid
3/2 "
3/9 TD 3031'
Lans. 292 7'
7" @ 2980'
1000 acid
Pump 75 Oil Pot
39° Gr.
Comp

COMPLETED

KANSAS Russell

Section 14 Township 15 Range 12W

Well No. 1 Kaufman

Company Plains Exploration

Hall-Gurney Pool

