

Russell

Map No. 55 Sec. 15 Twp. 15 R. 12WWell No. 1 Miller

Harry Gore

Company

FIRST REPORT

Contractor

NE SE NE

SECTION PLAT

Ft. from N. Line


990

Ft. from S. Line

330

Ft. from E. Line

Ft. from W. Line

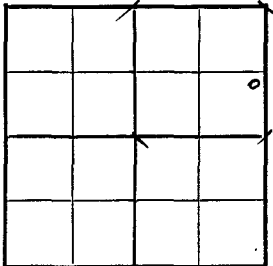

GUSTAFSON POOL

Location XXX

RECORD

Cased _____ in., _____ ft.

Sand _____

Gas _____

Oil _____

Total Depth _____

PRODUCTION

1st 24 hrs. Nat. _____

1st 24 hrs. after shot _____

Gas _____ Cu. Ft.

Dry Hole _____

Abandoned _____

Shell farmout

Date

SEP 9 1942 19

S. J. LEWIS Scout

Russell

KANSAS

Map No. 55 Sec. 15 Twp. 15 R. 12WWell No. 1 Miller

Harry Gore

Company

COMPLETED

Contractor

NE SE NE

SECTION PLAT

Ft. from N. Line


990

Ft. from S. Line

330

Ft. from E. Line

Ft. from W. Line

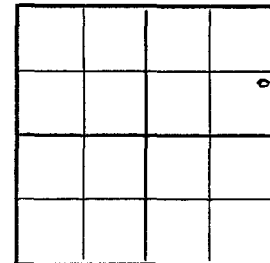

GUSTAFSON POOL

Location _____

RECORD

Cased _____ in., _____ ft.

Sand _____

Gas _____

Oil _____

Total Depth 2828

PRODUCTION

1st 24 hrs. Nat. _____

1st 24 hrs. after shot _____

Gas _____ Cu. Ft.

Dry Hole _____

Abandoned _____







Date

NOV 18 1942 19

S. J. LEWIS Scout

KANSAS Russell

Sec. 15 Twp. 15 R. 12-W

Well No. #1 Miller Farm

Harry Gore Company
(Gustafson Pool)


 Ft. from N. Line

990 Ft. from S. Line

330 Ft. from E. Line

 Ft. from W. Line

Elev. 1752

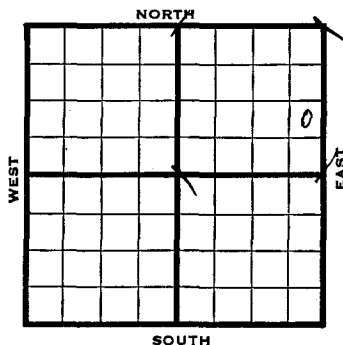

1942 REPORT

9/9 Location Shell farmout.
9/16 "
9/23 "
9/30 RUST
10/7 12" - 400' Drlg. 580'
10/14 Drlg. 1870'
10/21 2250 UR 8"
10/28 8" @ 2365
lans 2878
6" @ 2881 Drlg. 2898 SD
11/4 pay 2965-67
7" @ 2962 WOC
11/11 TD 2973'
Ripped csg. 2893 to 98
5500 Acid Testing
11/18 Lans. 2878
Ripped csg. 2893-98
7" @ 2962
T.D. 2973
Pump 289 bbl. Pot.
500 Acid
Gravity 39

COMPLETED

KANSAS

FORM 51 5M 10-41 PETROL

Russell

Section 15 Township 15 Range 12-W

Well No. #1 Miller

Company Harry Gore
Gustafson Pool

