

KANSAS Kansas Pool Name Hall-GurneyMap No. 55 Sec. 15 Twp. 15 R. 12WWell No. 1 Kastrup

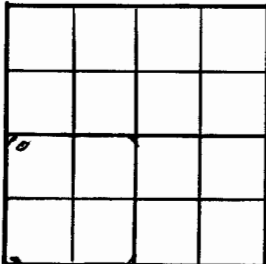
Harry Gore Company

FIRST REPORT

Contractor

NW SW

SECTION PLAT

330 Ft. from N. Line Ft. from S. Line Ft. from E. Line330 Ft. from W. Line

Russell County

Location

RECORD

Cased in, ft.Sand Gas Oil Total Depth

PRODUCTION

1st 24 hrs. Nat. 1st 24 hrs. after shot Gas Cu. Ft.Dry Hole Abandoned

Date

FEB 6 1946 19

S. J. LEWIS Scout

KANSAS Kansas Pool Name Hall-GurneyMap No. 55 Sec. 15 Twp. 15 R. 12WWell No. 3 Kastrup

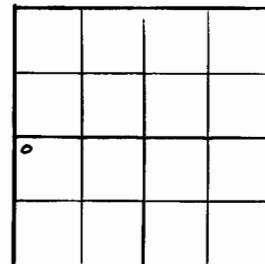
Harry Gore Company

CORRECTION

Contractor

NW SW

SECTION PLAT

330 Ft. from N. Line Ft. from S. Line Ft. from E. Line330 Ft. from W. Line

Russell County

Location

RECORD

Cased in, ft.Sand Gas Oil Total Depth

PRODUCTION

1st 24 hrs. Nat. 1st 24 hrs. after shot Gas Cu. Ft.Dry Hole Abandoned

Date

FEB 20 1946

S. J. LEWIS Scout

Kansas Pool Name Hall-Gurney
 Map No. 53 Sec. 15 Twp. 15 R. 12W
 Well No. 3 Kastrup

Harry-Gore Company
ABANDONED Contractor

NW SW

E. 1. 1791
SECTION PLAT

330 Ft. from N. Line
 _____ Ft. from S. Line
 _____ Ft. from E. Line
330 Ft. from W. Line

0			

Russell County

Location _____
 Rig up _____
 Drilling and Remarks:

CR 8240

RECORD

Cased _____ in., _____ ft.
 Sand _____
 Gas _____
 Oil _____
 Total Depth 3246

PRODUCTION

1st 24 hrs. Nat. _____
 1st 24 hrs. after shot _____
 Gas _____ Cu. Ft.
 Dry Hole _____
 Abandoned _____

Date

MAR 27 1946 19 S. J. LEWIS Scout

Sec. 15 Twp. 15 R. 12W

Well No. #1 Kastrup Farm

Harry Gore Company

Hall-Gurney

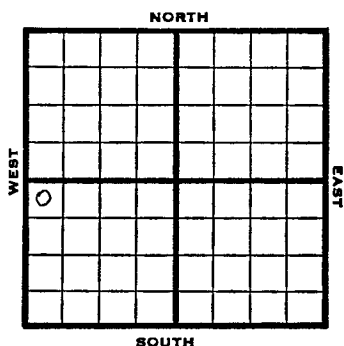
330 Ft. from N. Line

Ft. from S. Line

Ft. from E. Line

330 Ft. from W. Line

NW SW



1946 Elev. 1791' REPORT

2/6 Rig
2/14 Drlg. 200'
2/21 Anhy 695' 10" - 7715'
Drlg. 1160'
2/28 SD 2008'
3/7 Tarkio 2260' 8" - 2342'
Drlg. 2350'
3/14 Topeka 2570' 8" - 2408'
Drlg. 2580'
3/21 7" - 2935' Lans. 2940'
Drlg. 3040'
3/27 Arb. 3240
TD 3246'

ABANDONED

Section 15 Township 15 Range 12W

Well No. #1 Kastrup

Company Harry Gore

