

Map No. 55 Sec. 16 Twp. 15 R. 12WWell No. 1 F. Zemman

Central Petroleum

Company

FIRST REPORT

Contractor

SW SW NE

Ft. from N. Line

330 Ft. from S. Line

Ft. from E. Line

330 Ft. from W. Line

SECTION PLAT

WILDCAT

Location X

RECORD

Cased _____ in., _____ ft.

Sand _____

Gas _____

Oil _____

Total Depth _____

PRODUCTION

1st 24 hrs. Nat. _____

1st 24 hrs. after shot _____

Gas _____ Cu. Ft.

Dry Hole _____

Abandoned _____

Date

JAN 15 1941

19

S. J. LEWIS

Scout

Map No. 55 Sec. 16 Twp. 15 R. 12WWell No. 1 F. Zemman

Central Petroleum

Company

Contractor

ABANDONED

SW SW NE

Ft. from N. Line

330 Ft. from S. Line

Ft. from E. Line

330 Ft. from W. Line

SECTION PLAT

WILDCAT

Location _____

RECORD

Cased _____ in., _____ ft.

Sand _____

Gas _____

Oil _____

Total Depth 3304

PRODUCTION

1st 24 hrs. Nat. _____

1st 24 hrs. after shot _____

Gas _____ Cu. Ft.

Dry Hole _____

Abandoned _____

Date

APR 2 1941


19

S. J. LEWIS

Scout

KANSAS Russell
 FORM 252-A 5M 2-40
 Sec. 16 Twp. 15 R. 12-W
 Well No. #1 F. Zemman Farm _____
Central Petr. Company _____
 (Wildcat)

_____ Ft. from N. Line
330 Ft. from S. Line
 _____ Ft. from E. Line
330 Ft. from W. Line

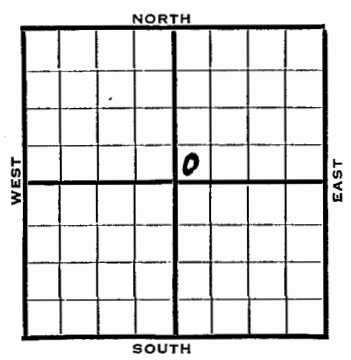

Elev. 1823

1941	REPORT
1/15	Location
1/23	"
1/30	"
2/6	Cable rig.
2/13	SD 275'
2/20	15" - 380' 12" - 550' Drlg. 840'
2/27	Anhy 731' Ft. Riley 1660' Drlg. 1735'
3/6	10" - 2030' Drlg. 2340'
3/13	Topeka 2670' Drlg. 2780'
3/20	Dodge 2901' 6" - 2961' Lans. 2965' T.D. 3134' UR 6".
3/27	6" - 3130' Cong. 3254' T.D. 3290' S.O.
4/2	Arb. 3292' T.D. 3304' Water.
	ABANDONED

KANSAS Russell
 Form 51-5M-7-40-Palace
 Section 16 Township 15 Range 12-W
 Well No. 1 F. Zemman
 Company Central Petroleum

