Form 26 200 Bks. 10-46 Petrol
Kansas

Hall-Gurney Pool

Map No. K55 Sec. 16 Twp. 15 R. 12W

Well No. 4 Zeman

Harry Gore Company

FIRST REPORT Contractor

SW NE NE

SECTION PLAT

990 Ft. from N. Line

Ft. from S. Line

990 Ft. from E. Line

Ft. from W. Line

Russell County

Location X

Rig up

Drilling and Remarks:

RECORD

Cased in., ft.

Sand

Gas

Oil

Total Depth

PRODUCTION

1st 24 hrs. Nat.

1st 24 hrs. after shot

Gas Cu. Ft.

Dry Hole

Abandoned

Date

APR 2 1947 19 S. J. LEWIS Scout

Form 26 200 Bks. 10-46 Petrol
Kansas

Hall-Gurney

Map No. 55 Sec. 16 Twp. 15 R. 12W

Well No. 4 Zeman

Harry Gore Company

COMPLETE Contractor

SW NE NE

E. 1818

SECTION PLAT

990 Ft. from N. Line

Ft. from S. Line

990 Ft. from E. Line

Ft. from W. Line

Russell County

Location

Rig up

Drilling and Remarks:

Cir 3235'
5" @ 3235
Pump 350 BO

8 9 5/8

RECORD

Cased in., ft.

Sand

Gas

Oil

Total Depth 3238'

PRODUCTION

1st 24 hrs. Nat.

1st 24 hrs. after shot

Gas Cu. Ft.

Dry Hole

Abandoned

Date

AUG 20 1947 19 S. J. LEWIS Scout

FORM 252-A
6M 12-46 PETROL

KANSAS Russell

Sec. 16 Twp. 15 R. 12W

Well No. #4 Zeman Farm

Lee Phillips
~~Harry Gore~~ Company

Hall-Gurney


990 Ft. from N. Line

Ft. from S. Line

990 Ft. from E. Line

Ft. from W. Line

SW NE NE

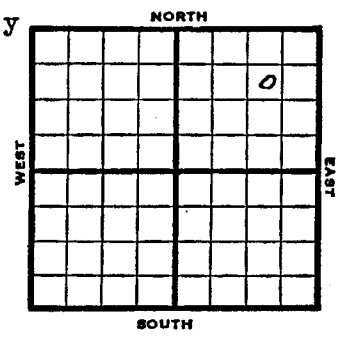

1947	REPORT
	Elev. 1818'
4/2	Location.
4/9	Rig
4/15	Rig
4/23	"
4/29	"
5/7	"
5/13	"
5/23	Drlg 161'
5/27	10" @ 725' Drlg. 890'
6/3	Drlg 1850'
6/10	8" @ 2010 Drlg. 2240'
6/17	8" @ 2413' Drlg 2415'
6/24	SD
7/1	Drlg 2356'

OVER

1947

7/8 8" @ 2355'
Drlg 2575'

7-16 Lansing 2944
Drlg. 3012

7/22 7" @ 3021'

7/29 "

8/6 Drlg 3160'

8/13 "

8/20 Arb 3235'
5" @ 3235'
Pump 500 Pot.
Gr. 39
T.D. 3238'
Completed

COMPLETED

O.W.W.O.

1952
6/4 Tarkio 2279 Top 2620
Lans. 2945 Arb. 3235
OTD 3238 5" @ 3235
MICT

6/11 Testing

6/18 NR

6/25 Oil Well TD 3238
Tar 2279 Top. 2620
Lans. 2943 Arb. 3235
OTD 3238 5" @ 3235 SP 3100
60/ in 90' break S/ 2 boph
1000 A Comp. 100 bopd

COMPLETED

FORM 275 FOR SALE BY KANSAS BLUE PRINT CO.

O.W.W.O.


County Russell State Kansas

Sec. 16 (Blk. Twp.) 15 (Sur. Rge.) 12W Map No.

Operator Lee Phillips (was Harry Gore)

Well No. 4 Farm Zeman

Elev. Location SW NE NE

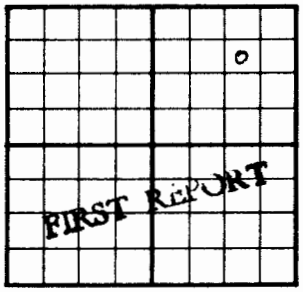

990 Ft. From N Line NE

990 Ft. From E Line Quarter

1st. Report JUN 4 1952

Completion

Remarks OWWO O.W.W.O.

Spudding Date O.W.W.O.

Drlg. Data

Tarkio 2279 Top. 2620 Lans. 2943

Arb. 3235 OTD 3238 5" @ 3235 MICT

J. G. McGEHEE

FORM 275 FOR SALE BY KANSAS BLUE PRINT CO.


County Russell State Kansas

Sec. 16 (Blk. Twp.) 15 (Sur. Rge.) 12W Map No.

Operator Lee Phillips (was Harry Gore)

Well No. 4 Farm Zeman

Elev. Location SW NE NE

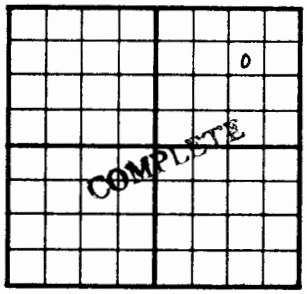

990 Ft. From N Line NE

990 Ft. From E Line Quarter

1st. Report

Completion JUN 25 1952

Remarks OWWO

Spudding Date

Drlg. Data Oil well TD 3238

Tarkio 2279 Top. 2620 Lans. 2943

Arb. 3235 OTD 3238 5" @ 3235

SP 3110 60/ in 90' break S/ 2 boph

1000 A Comp. 100 bopd

J. G. McGEHEE

KANSAS

FORM 51 10M 12-46 PETROL

O.W.W.O. Russell

Section 16 Township 15 Range 12W

Well No. 4 Zeman

Lee Phillips

Company Harry Gore

Hall-Gurney

