FORM 26 200 BKS 1-44 PETROL

Pool Name Forrest Hill

Map No. 5 Sec. 16 Twp. 15 R. 12 W

Well No. 1 Zeman

H. Gore et al Company

FIRST REPORT Contractor

C E L NW NE

SECTION PLAT

660 Ft. from N. Line

Ft. from S. Line

Ft. from E. Line

990 Ft. from W. Line

Russell

Location

Rig up

Drilling and Remarks:
Cable

RECORD

Cased in., ft.

Sand

Gas

Oil

Total Depth

PRODUCTION

1st 24 hrs. Nat.

1st 24 hrs. after shot

Gas Cu. Ft.

Dry Hole

Abandoned

Date

NOV 8 1944 19 S. J. LEWIS Scout

FORM 26 200 BKS 1-44 PETROL

Pool Name Forrest Hill

Map No. 5 Sec. 16 Twp. 15 R. 12W

Well No. 3 Zeman

Harry Gore et al Company

CORRECTION Contractor

C E L NW NE

SECTION PLAT

660 Ft. from N. Line

Ft. from S. Line

Ft. from E. Line

990 Ft. from W. Line

Russell

Location

Rig up

Drilling and Remarks:
Reported as
#1 Zeman

RECORD

Cased in., ft.

Sand

Gas

Oil

Total Depth

PRODUCTION

1st 24 hrs. Nat.

1st 24 hrs. after shot

Gas Cu. Ft.

Dry Hole

Abandoned

Date

NOV 2 9 1944 19 S. J. LEWIS Scout

FORM 56 200 BKS, 1-44 PETROL

KANSAS Kansas Pool Name Forrest Hill

Map No. 55 Sec. 16 Twp. 15 R. 12W

Well No. 3 Zeman

Harry Gore etal Company

COMPLETED Contractor

C E L NW NE E1/1819


SECTION PLAT

660 Ft. from N. Line

Ft. from S. Line

Ft. from E. Line

990 Ft. from W. Line

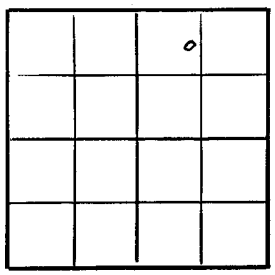

Russell County

Location

Rig up

Drilling and Remarks:

Lime 2945
7" @3018'
4000 Acid
Flow 116 BOF
36° Gr

RECORD

Cased in., ft.

Sand

Gas

Oil

Total Depth 3030

PRODUCTION

1st 24 hrs. Nat.

1st 24 hrs. after shot

Gas Cu. Ft.

Dry Hole

Abandoned

Date

JUL 1 8 1945 19

S. J. LEWIS Scout

O.W.W.O.

FORM 56 200 BKS, 1-44 PETROL

KANSAS Russell County KANSAS

Sec. 16 Twp. 15 R. 12W

Well No. #3 Zeman Farm

Lee Phillips
H. Gore et al Company


Forrest Hill

660 Ft. from N. Line

Ft. from S. Line

Ft. from E. Line

990 Ft. from W. Line

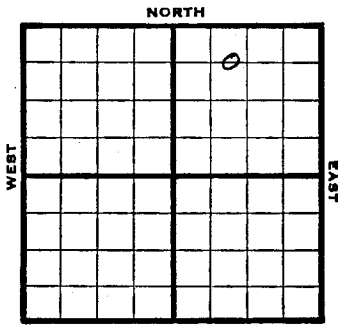

E/2 ~~SE~~ NW NE Elev 1819

1944	REPORT
11/8	Cable
11/16	"
11/24	"
11/29	"
12/6	"
12/14	Cable rig
12/21	" "
12/29	" "
1945 1/3	" "
1/10	" "
1/17	" "
1/26	" "
1/31	" "
2/7	" "
2/14	" "
2/21	" "
2/28	" "
3/7	" "
3/14	" "
3/23	" "
3/29	" "

OVER

O.W.W.O.

FORM 513 REV. SUNRAY OWWO

County Russell Elev. 1818

Sec. 16 Twp. 15 Rge. 12W

Company Lee Phillips

Farm Name Zeman No. 3

TOPS	DEPTH	LOG	DATUM
Anh.			
Tp.	2620		
H.			
Tr.	2279		
Dg.			
Bl.			
L.	2945		
K.C.			
B.K.C.			
Ce.			
C.			
M.			
M.			
K.			
Mz.			
Mo.			
V.			
S.			
S.			
A			
R.			
P€.			
G. Gorham	3233		
TD	3030		

Loc. in Sec. C E½ NW NE

Geol.

Contr.

Pool

C

FIRST REPORT JUN 22 '55 COMPLETE

Date Comm.

DD 3239 7" @ 3018 5" @ 3210

FU 1500' fluid 1 hr. 80% wtr.

S/ 20 bfph 98% wtr. 10 hr. PB 3028

P/ 10 bopd 2 bw Comp.

Co. Lse. No. Sec. T. R.

O. W. D. D

OWDD

FORM 513 REV. SUNRAY

County Russell Elev. 1819 DF

Sec. 16 Twp. 15S Rge. 12W

Company Lee Phillips

Farm Name Zeman No. 3

TOPS	DEPTH	LOG	DATUM
Anh.			
Tp.			
H.			
Tr.			
Dg.			
Bl.			
L.	2945		1126
K.C.			
B.K.C.			
Ce.			
C.			
M.			
M.			
K.			
Mz.			
Mo.			
V.			
S.			
S.			
A			
R.			
P€.			
G.			
TD			

Loc. in Sec. E/2 NW NE

Geol.

Contr.

Pool

O

FIRST REPORT JUL 13 '55 COMPLETE

Date Comm.

old info: OTD 3030; 7" 3018 - was Lans. well

New info: DD Gorham 3233; TD 3239; 5" 3210

Swb 20 bflph (98% wtr) pull 5" PB 3028

P 10 bo plus 2 bwpd Comp.

Co. Lse. No. Sec. T. R.

1945

4/5 Cable rig
4/12 " "
4/20 " "
4/27 Drlg. 200'
5/3 10" @ 485
10" @ 732
Anhy 715
Drlg. 1025
5/10 Drlb. 1990'
5/17 8" @ 2005
2200' fsg.
5/24 2240 UR 8"
5/31 8" @ 2408
Drlg. 2720
6/8 Topeka 2605 Lasn 2938- 7" @ 2993
Drlg. 3016
6/14 Lams 2945 corrected
7" @ 3018
TD 3030'
2700' oil
3000 acid
6/21 Temp Pot 25 oil
6/28 " " "
7/3 Flow 5 oil per hr 10 hrs.
Est. 10 M. Gas
7/11 " " " " " "
7/18 Lans 2945
7" @ 3018'
4000 acid.
TD 3030
Flow 116 Pot.
Grav. 36.0

COMPLETED

1955

O.W.W.O.

6/22 DD 3239' 7" @ 3018 5" @ 3210
FU 1500' fluid 1 hr. 80% wtr.
S/20 BFPH 98% wtr. 10 hr. PB 3028
P/10 BOPD 2 BW Comp.
Tp. 2620' Tr. 2279' L. 2945'
Gorham 3233', TD 3030'

FIRST REPORT
←
COMPLETED

---

3 Zeman

O. W. D. D

1955
7/13 Old Info: OTD 3030'
7" @ 3018' - Was Lans. well.
NEW INFO: DD Gorham 3233'
TD 3239' 5" @ 3210
Swb 20 BFPH (98% wtr) Pull 5"
PB 3028' P/10 BO + 2 BWPD.
L. 2945'

FIRST REPORT
←
COMPLETED

O.W.W.O.
FORM 51 5M BRIX

KANSAS Russell County KANSAS

O. W. D. D

Section 16 #3 Township 15 Range 12W

Well No. ~~#1~~ Zeman

Company ~~H. Gore et al~~ Lee Phillips

