

Map No. _____ Sec. 16 Twp. 15 R. 12W


Well No. 2 Rouback "B"

Harbar etal. _____ Company

FIRST REPORT _____ Contractor

SE SW SW

SECTION PLAT

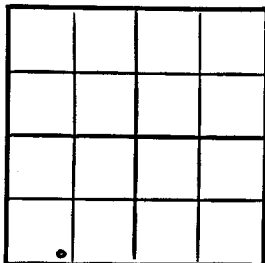

_____ Ft. from N. Line

330 _____ Ft. from S. Line

_____ Ft. from E. Line

990 _____ Ft. from W. Line

Russell County

Location _____

RECORD

Cased _____ in., _____ ft.

Sand _____

Gas _____

Oil _____

Total Depth _____

PRODUCTION

1st 24 hrs. Nat. _____

1st 24 hrs. after shot _____

Gas _____ Cu. Ft.

Dry Hole _____

Abandoned _____

R U R

Date

JAN 1 9 1949 19

S. J. LEWIS Scout

Map No. 25 Sec. 16 Twp. 15 R. 12W

Well No. 2 Rouback "B"


Harbar etal. _____ Company

ABANDONED

Contractor

SE SW SW

SECTION PLAT

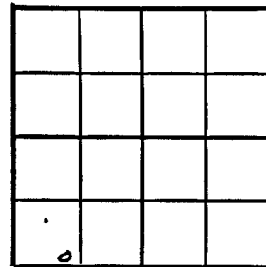

_____ Ft. from N. Line

330 _____ Ft. from S. Line

_____ Ft. from E. Line

990 _____ Ft. from W. Line

Russell County

Location _____

RECORD

Cased _____ in., _____ ft.

Sand _____

Gas _____

Oil _____

Total Depth 3242

PRODUCTION

1st 24 hrs. Nat. _____

1st 24 hrs. after shot _____

Gas _____ Cu. Ft.

Dry Hole _____

Abandoned _____

Rig up _____

Drilling and Remarks:

Art 3238

Date

MAR 2 1949 19

S. J. LEWIS Scout

Form 26 200 Bks. 11-49 Petrol ~~Kansas~~ OWDD for SWD
Map No. _____ Sec. 16 Twp. 15 R. 12W
Well No. 2 Rouback "B"
Harbar etal. _____ Company

Contractor
SW SW SW E/1798
SECTION PLAT

Ft. from N. Line
330 Ft. from S. Line

Ft. from E. Line
330 Ft. from W. Line



Russell County

Location _____

Rig up _____

Drilling and Remarks:

OTD 3255
5" @ 3242
now drlg. @ 3294

RECORD

Cased _____ in., _____ ft.
Sand _____
Gas _____
Oil _____
Total Depth _____

PRODUCTION

1st 24 hrs. Nat. _____
1st 24 hrs. after shot _____
Gas _____ Cu. Ft.
Dry Hole _____
Abandoned _____

Date


FEB 15 1950 19 J. E. TYRA Scout

Form 26 200 Bks. 11-49 Petrol ~~Kansas~~ OWDD for SWD
Map No. _____ Sec. 16 Twp. 15 R. 12W
Well No. 2 Rouback "B"
Harbar etal. _____ Company

Contractor
SE SW SW E/1798
SECTION PLAT

Ft. from N. Line
330 Ft. from S. Line

Ft. from E. Line
990 Ft. from W. Line

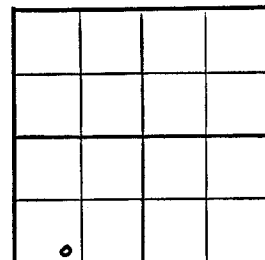

Russell County

Location _____

Rig up _____

Drilling and Remarks:

Reported
SW SW SW

RECORD

Cased _____ in., _____ ft.
Sand _____
Gas _____
Oil _____
Total Depth _____

PRODUCTION

1st 24 hrs. Nat. _____
1st 24 hrs. after shot _____
Gas _____ Cu. Ft.
Dry Hole _____
Abandoned _____

Date

FEB 15 1950 19 J. E. TYRA Scout

Kansas

Map No. _____ Sec. 16 Twp. 15 R. 12W

Well No. 2 Rouback "B" SWD


Harbar et al. _____ Company

SE SW SW

Elev. 1798

Contractor

SECTION PLAT

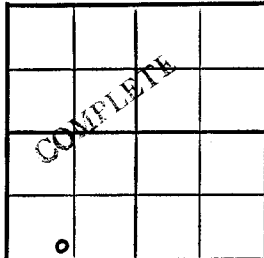

Ft. from N. Line

330 Ft. from S. Line

Ft. from E. Line

990 Ft. from W. Line

Russell County

Location _____

Rig up _____

Drilling and Remarks:

5" @ 3242

arb. 3313

T.D. 3434

Input 150 bopd
SWD

RECORD

Cased _____ in., _____ ft.

Sand _____

Gas _____

Oil _____

Total Depth _____

PRODUCTION

1st 24 hrs. Nat. _____

1st 24 hrs. after shot _____

Gas _____ Cu. Ft.

Dry Hole _____

Abandoned _____

Date

MAR 22 1950 19 J. E. TYRA Scout

KANSAS

Russell

Sec. 16 Twp. 15 R. 12W ✓

Well No. #2 Rouback "B" Farm

Harbar et al

Company


Forest Hill Pool

Ft. from N. Line

330' Ft. from S. Line

Ft. from E. Line

990' Ft. from W. Line

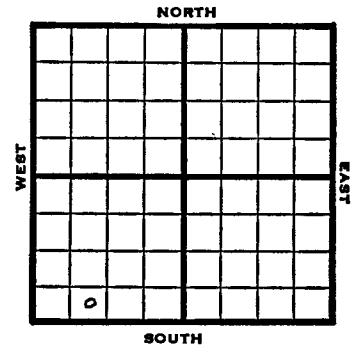

SE SW SW

1949

Elev 1798'

REPORT

1/19

RUR

1/26

8" @ 450

Drlg 1860'

2/2

Drlg. 2990'

2/9

Arb. 3241-44'

TD 3244'

5" @ 3244'

2/16

Lansing 2944'

2/23

TD 3255'

3/2

TD 3242'

Arb. 3239'

Aband.

ABANDONED

1950

2/15

OTD 3255'

5" @ 3242'

Now drlg. @ 3294'

3/22

5" @ 3242'

Arb. 3313'

TD 3434'

Input 150 BOPD

SWD

Aband.

ABANDONED

KANSAS Russell

O.W.D.D

Section 16 Township 15 Range 12WWell No. 2 Rouback "B"Company Harbar et al

Forest Hill

NORTH

WEST

EAST

SOUTH

0