


County Russell State Kansas
 Sec. 16 (Blk. 16 (Sur. 12W Map No.

Operator Harbar Drlg.

Well No. 3 Farm Rouback "A"

Elev. _____ Location C S L SE SE

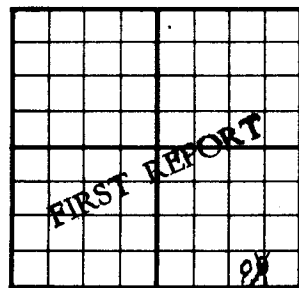

330 Ft. From S Line SE

660 Ft. From E Line Quarter

1st. Report MAY 29 1951

Completion _____

Remarks _____

Harbar Drlg. - Contr.

Spudding Date 5-27-51

Drig. Data Forest Hill Pool

8" @ 238

J. E. TYRA

Form 26 200 Bks. 11-49 Petrol

correction
Kansas

Map No. _____ Sec. 16 Twp. 15 R. 12W


Well No. 3 Rouback "A"

Harbar Drlg. Company

CORRECTION Contractor

SW SE SE

SECTION PLAT

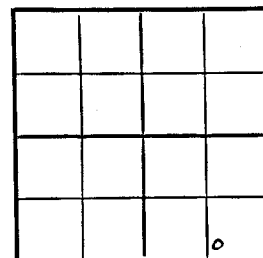

_____ Ft. from N. Line

330 Ft. from S. Line

990 Ft. from E. Line

_____ Ft. from W. Line

Russell County

Location _____

Rig up _____

Drilling and Remarks:

Reported

C S L SE SE

RECORD

Cased _____ in., _____ ft.

Sand _____

Gas _____

Oil _____

Total Depth _____

PRODUCTION

1st 24 hrs. Nat. _____

1st 24 hrs. after shot _____

Gas _____ Cu. Ft.

Dry Hole _____

Abandoned _____

Date

MAY 29 1951 19

J. E. TYRA

Scout

Russell

KANSAS

Sec. 16 Twp. 15 R. 12 W

Well No. # 3 Rouback "A" Farm

Harbar Drlg. Company

Harbar Drlg. Contractor


Forest Hill Pool

Ft. from N. Line

330 Ft. from S. Line

990
660 Ft. from E. Line

Ft. from W. Line

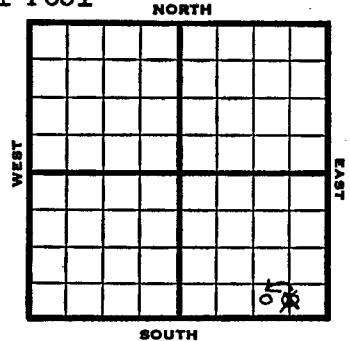~~C S L SE SE~~
SW SE SE

County Russell State Kansas
 Sec. 16 (Blk.) 15 (Sur.) 12W Map No.
 Operator Harbar Drlg.
 Well No. 3 Farm Rouback "A"
 Elev. 1840 Location SW SE SE

330 Ft. From S Line SE

990 Ft. From E Line Quarter

1st. Report

Completion JUN 13 1951

Remarks Forest Hill

Harbar Drlg. - Contr.

Spudding Date 5-27-51

Drlg. Data D & A TD 3310

8" @ 238 Anhy 745 Arb. 3303-10TD
 D & A

J. E. TYRA

1951 Elev. 1840' REPORT

5/29 Spud 5-27-51
 8" @ 238

6/13 Spud 5-27-51
 D & A TD 3310' 8" @ 238
 Anhy 745' Arb. 3303-10 TD
 D & A

ABANDONED

Russell

KANSAS

Section 16 Township 15 Range 12WWell No. #3 Roubach "A"Company Harbar Drlg.