

Russell

KANSAS

Sec. 16 Twp. 15 R. 12 W

Well No. # 2 Rouback "A" Farm

Harbar Drlg. Company

Contractor

Forest Hill Pool


Ft. from N. Line

330 Ft. from S. Line

Ft. from E. Line

990 Ft. from W. Line

SE SW SE

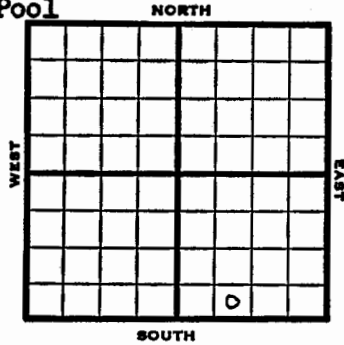


Russell KANSAS

Section 16 Township 15 Range 12W

Well No. #2 Rouback "A"

Company Harbar Drlg.

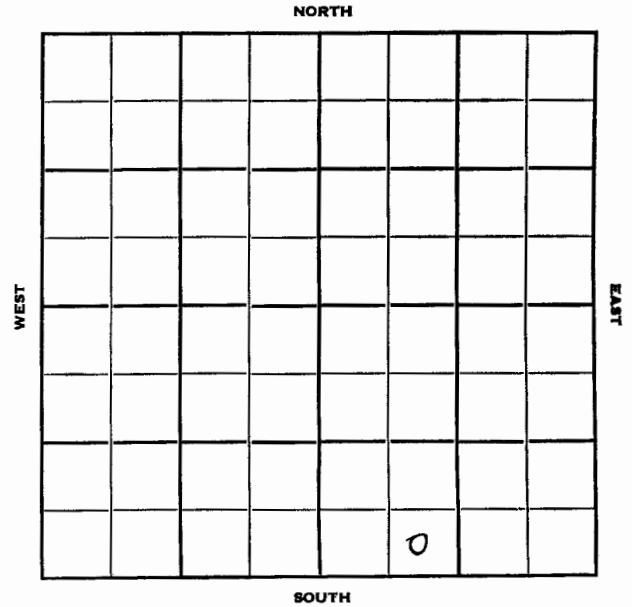

1951 Elev. 1842' REPORT

4/4 Spud 4-2-51
8" @ 240' WOC

5/16 Spud 4-2-51
Oil well TD 3278' 8" @ 240'
Arb. 3271-78' 5" @ 3272'
TD 3278' S/11 boph
Comp. 248 BOPD

COMPLETED