

Kansas

Map No. \_\_\_\_\_ Sec. 17 Twp. 15 R. 12W

Well No. 1 Brack

W. H. Black Company

Contractor

C E L N E

SECTION PLAT



1320 Ft. from N. Line

Ft. from S. Line

660 Ft. from E. Line

Ft. from W. Line

Russell County

Location \_\_\_\_\_

Rig up \_\_\_\_\_

Drilling and Remarks:

M I M

RECORD

Cased \_\_\_\_\_ in., \_\_\_\_\_ ft.

Sand \_\_\_\_\_

Gas \_\_\_\_\_

Oil \_\_\_\_\_

Total Depth \_\_\_\_\_

PRODUCTION

1st 24 hrs. Nat. \_\_\_\_\_

1st 24 hrs. after shot \_\_\_\_\_

Gas \_\_\_\_\_ Cu. Ft.

Dry Hole \_\_\_\_\_

Abandoned \_\_\_\_\_

Date

FEB 22 1950 19

J. E. TYRA Scout

Kansas

Map No. \_\_\_\_\_ Sec. 17 Twp. 15 R. 12W


Well No. 1 Brack

W. H. Black Company

Contractor

C E L N E

E. 1845 SECTION PLAT

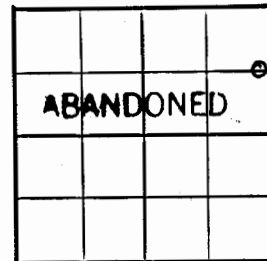

1320 Ft. from N. Line

Ft. from S. Line

660 Ft. from E. Line

Ft. from W. Line

Russell County

Location \_\_\_\_\_

Rig up \_\_\_\_\_

Drilling and Remarks:

8" @ 280

5" @ 3304

K.C. 2999

amb 3303

D+A

RECORD

Cased \_\_\_\_\_ in., \_\_\_\_\_ ft.

Sand \_\_\_\_\_

Gas \_\_\_\_\_

Oil \_\_\_\_\_

Total Depth 3312

PRODUCTION

1st 24 hrs. Nat. \_\_\_\_\_

1st 24 hrs. after shot \_\_\_\_\_

Gas \_\_\_\_\_ Cu. Ft.

Dry Hole \_\_\_\_\_

Abandoned \_\_\_\_\_

Date

MAR 15 1950 19

J. E. TYRA Scout

KANSAS Russell

Sec. 17 Twp. 15 R. 12-W

Well No. #1 Brack Farm  
W H Black Company


1320 Ft. from N. Line

Ft. from S. Line

660 Ft. from E. Line

Ft. from W. Line

C E L N E

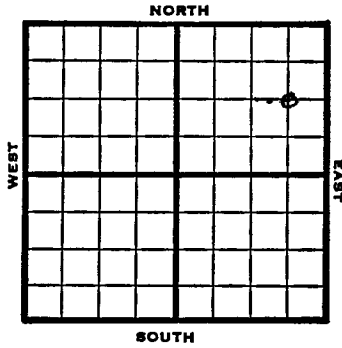

1950 Elev 1845' REPORT

2/22 MIM  
 3/15 TD 3312'  
 8" @ 280'  
 5" @ 3304'  
 KC 2999'  
 Arb. 3303'  
 D&A  
 Aband.

**ABANDONED**

KANSAS Russell

Section 17 Township 15 Range 12-W

Well No. #1 Brack

Company W H Black

