

Map No. _____ Sec. 18 Twp. 15 R. 12W

Well No. 4 Parker "A"

Skelly _____ Company

SE NW NW

Contractor
FIRST REPORT
SECTION PLAT

990 Ft. from N. Line

_____ Ft. from S. Line

_____ Ft. from E. Line

990 Ft. from W. Line

o			

Russell County

Location _____

Rig up _____

Drilling and Remarks:

Anhy 790

8" @ 804

RECORD

Cased _____ in, _____ ft.

Sand _____

Gas _____

Oil _____

Total Depth _____

PRODUCTION

1st 24 hrs. Nat. _____

1st 24 hrs. after shot _____

Gas _____ Cu. Ft.

Dry Hole _____

Abandoned _____

Date

NOV 2 1949 19 S. J. LEWIS Scout

Map No. _____ Sec. 18 Twp. 15 R. 12W

Well No. 4 Parker "A"

Skelly _____ Company

COMPLETE

SE NW NW

Contractor
11/18/49
SECTION PLAT

990 Ft. from N. Line

_____ Ft. from S. Line

_____ Ft. from E. Line

990 Ft. from W. Line

o			

Russell County

Location _____

Rig up _____

Drilling and Remarks:

Lans 317

Cu 7329

5" @ 3153

P. Hane.

Good

Pump 1890 ft. P. H.

392 ft.

Date

DEC 14 1949 19 S. J. LEWIS Scout

Russell KANSAS

Sec. 18 Twp. 15 R. 12W

Well No. #4 Parker "A" Farm

Skelly Company

Contractor

Parker Pool


990' Ft. from N. Line

Ft. from S. Line

Ft. from E. Line

990' Ft. from W. Line

SE NW NW

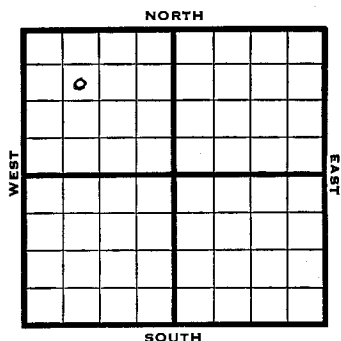

1949 Elev. 1850' REPORT

11/2 Anhy 790'
8" @ 804'
11/9 Lansing 3017'
Arbuckle 3339'
11/16 TD 3351'
5" @ 3153'
11/23 "
11/29 "
12/7 "
12/14 Lans. 3017'
Arb 3329'
5" @ 3153'
Perf. Lans.
Acid 3500
Pump 139 oil Pot.
Gr. 390
TD 3151'
COMPLETED

Russell KANSAS

Section 18 Township 15 Range 12W

Well No. #4 Parker "A"

Company Skelly

