

Map No. _____ Sec. 18 Twp. 15 R. 12W

Well No. 1 Parker "B"

Skelly _____ Company

FIRST REPORT _____ Contractor

NW SE


SECTION PLAT

330 Ft. from N. Line

_____ Ft. from S. Line

_____ Ft. from E. Line

330 Ft. from W. Line

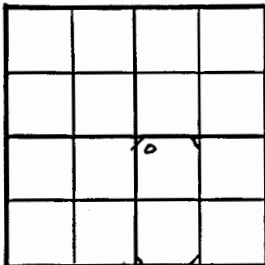

Russell County

Location _____

Rig up _____

Drilling and Remarks:

Anhy 772

8" @ 780

RECORD

Cased _____ in., _____ ft.

Sand _____

Gas _____

Oil _____

Total Depth _____

PRODUCTION

1st 24 hrs. Nat. _____

1st 24 hrs. after shot _____

Gas _____ Cu. Ft.

Dry Hole _____

Abandoned _____

Date

NOV 17 1948 19 S. J. LEWIS Scout

Map No. 55 Sec. 18 Twp. 15 R. 12W

Well No. 1 Parker "B"

Skelly _____ Company

ABANDONED _____ Contractor

NW SE


SECTION PLAT

330 Ft. from N. Line

_____ Ft. from S. Line

_____ Ft. from E. Line

330 Ft. from W. Line

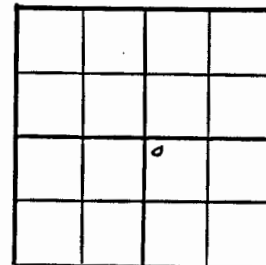

Russell County

Location _____

Rig up _____

Drilling and Remarks:

Lans 3012

Q2 X 2807

RECORD

Cased _____ in., _____ ft.

Sand _____

Gas _____

Oil _____

Total Depth 3328

PRODUCTION

1st 24 hrs. Nat. _____

1st 24 hrs. after shot _____

Gas _____ Cu. Ft.

Dry Hole _____

Abandoned _____

Date

DEC 1 1948 19 S. J. LEWIS Scout

KANSAS Russell

Sec. 18 Twp. 15 R. 12W ✓

Well No. 1 Parker "B" Farm

Skelly Company

Parker Pool


330 Ft. from N. Line

_____ Ft. from S. Line

_____ Ft. from E. Line

330 Ft. from W. Line

NW SE

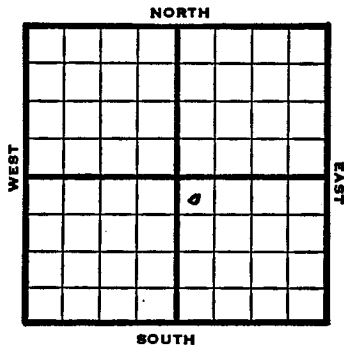

1948 Eli 1835' REPORT

11/17 Anhy 772
8" @ 780'
11/23 Drlg 1800'
12/1 TD 3328'
Lansing 3012'
Arb 3307'
Aband.

ABANDONED

KANSAS Russell

Section 18 Township 15 Range 12W

Well No. 1 Parker "B"

Company Skelly

Parker Pool

NORTH

