

Map No. 55 Sec. 18 Twp. 15 R. 12WWell No. 1 Hilgenberg "B"

Central Petroleum et al Company

FIRST REPORT ContractorC S $\frac{1}{2}$ SE NE


Ft. from N. Line

330 Ft. from S. Line660 Ft. from E. Line

Ft. from W. Line

WILDCAT

SECTION PLAT

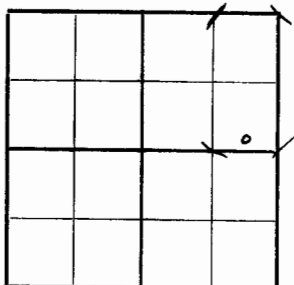

Location

Rig up

Drilling and Remarks:

Move in Rotary Tools

RECORD

Cased in, ft.

Sand

Gas

Oil

Total Depth

PRODUCTION

1st 24 hrs. Nat.

1st 24 hrs. after shot

Gas Cu. Ft.

Dry Hole

Abandoned

Date

AUG 13 1941

S. J. LEWIS Scout

KANSAS

Map No. 1-55 Sec. 18 Twp. 15 R. 12WWell No. 1 Hilgenberg "B"

Central Petroleum et al Company

ABANDONED Contractor

C S L SE NE


Ft. from N. Line

330 Ft. from S. Line660 Ft. from E. Line

Ft. from W. Line

WILDCAT

SECTION PLAT

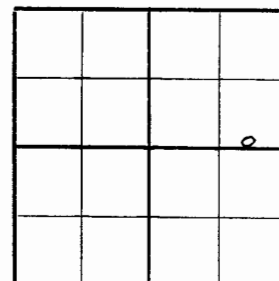

Location

Rig up

Drilling and Remarks:

Cor 433 18.
 5 4033 11
 No Feb.

RECORD

Cased in, ft.

Sand

Gas

Oil

Total Depth 3326

PRODUCTION

1st 24 hrs. Nat.

1st 24 hrs. after shot

Gas Cu. Ft.

Dry Hole

Abandoned

Date

OCT 1 1941 19

S. J. LEWIS Scout

Sec. 18 Twp. 15 R. 12-W

Well No. 1 Hilgenberg "B" Farm
Central petroleum et al Company
(wildcat)


Ft. from N. Line

330 Ft. from S. Line

660 Ft. from E. Line

Ft. from W. Line

Elev. 1867

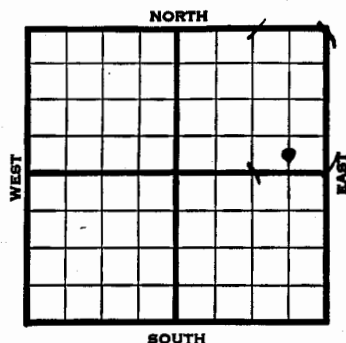

1941 REPORT

8/13 Move in Roty Tools

8/21 8" - 270' Anhy 790'
Ft. Riley 1730' Drlg. 2124'

8/28 Topeka 2699' Lans. 3022'
Cong. 3304' Arb. 3310-15' T.D.
S.O. Run csg.

9/4 5" - 3311' T.D. 3326'
P.B. to 3324' 500 acid.

9/11 P.B. to 3322' 750 Butane
1000 acid.

9/18 1000 acid. Pump 8½ oil & 4½
water 1 hour.

9/25 " "

10/1 Arb. 3318'
5" - 3311'
T.D. 3326' Water.

ABANDONED

Section 18 Township 15 Range 12W

Well No. 1 Hilgenberg "B"

Company Central petroleum et al

