



Russell KANSAS  
15 12W

Sec. 21 Twp. 15 R. 12W

Well No. #3 Krause Farm

Duke & Wood Company

Contractor

Dubuque Pool


990' Ft. from N. Line

Ft. from S. Line

330' Ft. from E. Line

Ft. from W. Line

SE NE NE

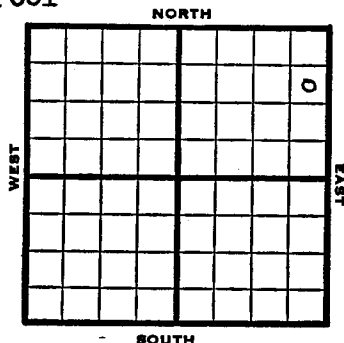


Russell KANSAS

Section 21 Township 15 Range 12W

Well No. #3 Krause

Company Duke & Wood

NORTH

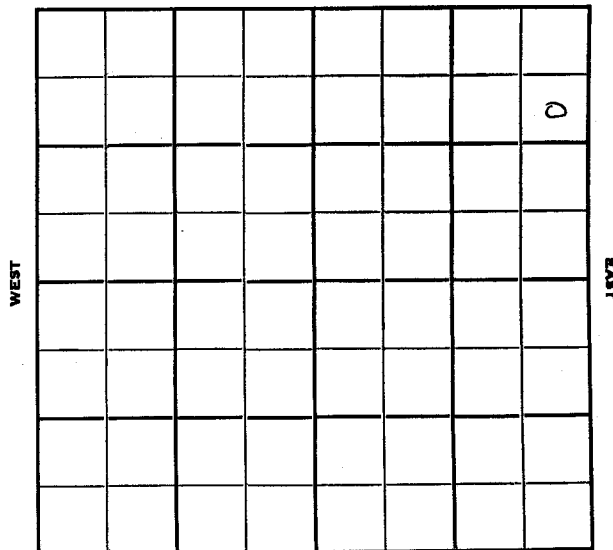

SOUTH

1950 Elev. 1783' REPORT

11/29 Spud 11-27-50

1951  
1/17 Spud 11-27-50

Oil Well TD 3268  
8" @ 150' Anhy 668'  
Heeb. 2847 Dodge 2861  
Lans. 2935' Cong. 3234  
Arb. 3237-68 5" @ 3267  
TD 3268 S/15 boph 18/3246-49  
500 A Comp. 298 bopd

COMPLETED