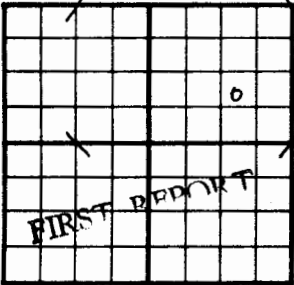
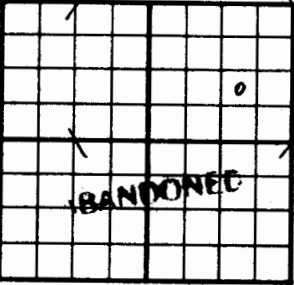


County	Russell	State	Kansas
Sec.	22	(Bk. Twp.)	15
		(Sur. Rge.)	12W
Operator	Fred Haynes		
Well No.	1 Farm Miller "B"		
Elev.	NW SE NE		
	990 Ft. From S Line NE		
	990 Ft. From E Line Quarter		
	1st. Report DEC 10 1952		
	Completion		
	Remarks		
Haynes - Contr.			
Spudding Date 12-1-52			

Drig. Data

12" @ 385 drlg. 625

J. G. McGEHEE

County	Russell	State	Kansas
Sec.	22	(Bk. Twp.)	15
		(Sur. Rge.)	12W
Operator	Fred Haynes		
Well No.	1 Farm Miller "B"		
Elev.	1859 Location NW SE NE		
	990 Ft. From S Line NE		
	990 Ft. From E Line Quarter		
	1st. Report		
	Completion JAN 3 1953		
	Remarks		
Haynes - Contr.			
Spudding Date 12-1-52			

Drig. Data **D & A TD 3336****12" @ 385 10" @ 745 8" @ 2075****KC 3030 Cong. 3315 5" @ 3258 TD 3336****D & A**

J. G. McGEHEE

Russell KANSAS ✓

Sec. 22 Twp. 15 R. 12 WWell No. # 1 Miller "B" Farm

Fred Haynes Company

Haynes Contractor


Ft. from N. Line

990 Ft. from S. Line

990 Ft. from E. Line

Ft. from W. Line

NW SE NE

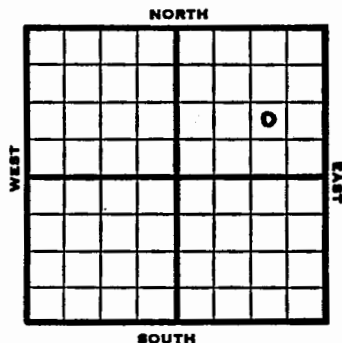

1952 Elev. 1859' REPORT

12/10 Spud 12-1-52
12" @ 385
Drlg. 625'

12/11 Ø625

12/18 Ø1550

12/25 " "

1/1 NR

1/8 Drlg. 2800

1/23 Spud 12-1-52

D&A

TD 3336

12" @ 385

10" @ 745

8" @ 2075

KC 3030, Cong 3315

5" @ 3258

TD 3336

D&A

ABANDONED

Russell KANSAS

Section 22 Township 15 Range 12 WWell No. 1 Miller "B"Company Fred Haynes