

Russell

Map No. 55 Sec. 22 Twp. 15 R. 12WWell No. 1 Miller

Phil-Han et al.

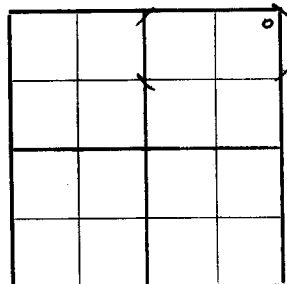
Company

FIRST REPORT

Contractor

NE/C

SECTION PLAT

330 Ft. from N. Line

Ft. from S. Line

330 Ft. from E. Line

Ft. from W. Line

WILDCAT

Location

Rig up

Drilling and Remarks:

Surface Hole

RECORD

Cased in, ft.

Sand

Gas

Oil

Total Depth

PRODUCTION

1st 24 hrs. Nat.

1st 24 hrs. after shot

Gas Cu. Ft.

Dry Hole

Abandoned

Date

APR 1 1942 19 S. J. LEWIS Scout

Russell

Map No. 55 Sec. 22 Twp. 15 R. 12WWell No. 1 Miller

Phil-Han et al.

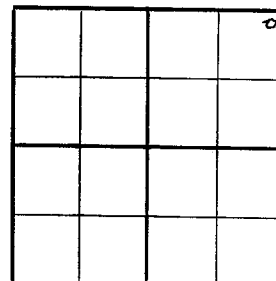
Company

ABANDONED

Contractor

NE/C

SECTION PLAT

330 Ft. from N. Line

Ft. from S. Line

330 Ft. from E. Line

Ft. from W. Line

WILDCAT

Location

Rig up

Drilling and Remarks:

As 8288Quartzite 3311Noe lower

RECORD

Cased in, ft.

Sand

Gas

Oil

Total Depth 3315

PRODUCTION

1st 24 hrs. Nat.

1st 24 hrs. after shot

Gas Cu. Ft.

Dry Hole

Abandoned

Date

APR 22 1942 19 S. J. LEWIS Scout

KANSAS

Russell

Sec 22 Twp. 15 R. 12-W

Well No. #1 Miller Farm

Phil-Han et al Company

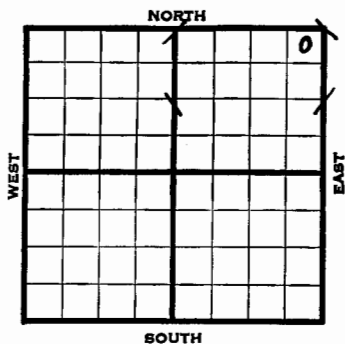
(Wildcat)

330 Ft. from N. Line

Ft. from S. Line

330 Ft. from E. Line

Ft. from W. Line



Elev. 1803

REPORT

1942
4/1 Surface hole.
4/8 8" - 324' Anhy. 705' Drlg. 1890'
4/15 Lans. 2957' Cong. 3251' Arb. 3288'
Drlg. 3297'

4/22 Arb. 3288'
Quartzite 3311'
T.D. 3315'
No shows.

ABANDONED

KANSAS

Russell

FORM 51 5M 10-41 PETROL

Section 22 Township 15 Range 12-W

Well No. #1 Miller

Company Phil-Han et al

NORTH Wildcat

