

County Russell State Kansas
 Sec. 22 (Blk. Twp.) 15 (Sur. Rge.) 12W Map No.
 Operator Fleming & Woodman
 Well No. 4 Farm Jaune
 Elev. _____ Location SE SW SE

330 Ft. From S Line SE
990 Ft. From W Line Quarter
 Ist. Report JUL 22 1953
 Completion _____
 Remarks _____
Fleming & Woodman - Contr.
 Spudding Date 7-19-53

Drig. Data Hall-Gurney Pool
8" @ 126 WOC

J. G. McGEHEE

County Russell State Kansas
 Sec. 22 (Blk. Twp.) 15 (Sur. Rge.) 12W Map No.
 Operator Fleming & Woodman
 Well No. 4 Farm Jaune
 Elev. 1864 Location SE SW SE

330 Ft. From S Line SE
990 Ft. From W Line Quarter
 Ist. Report _____
 Completion SEP 30 1953
 Remarks Hall-Gurney Pool
Fleming & Woodman - Contr.
 Spudding Date 7-19-53

Drig. Data Gas well TD 3333
8" @ 126 Anhy 760 Heeb. 2916
Dodge 2937 Er. lime 3004 Lans. 3016
DST 3023-98 open 1/2 hr. Rec. 190' gdm
120' o & gcm 920# DST 3194-3210
open 1/2 hr. Rec. 15' mud & VSSO 390#
Cong. 3289 DST 3294-3314 open 55 min.
Rec. 97' ocm TD 3314 5" @ 3299
DD 3333 PB 3200 24/ 3158-66 15/ 3160-
65 500 A S/ 4 bfph 85% wtr. 8 hr.
PB 3230 24/ 3086-75 wtr. SP 3070
24/ 3041-48 wtr & gas 500 A
Comp. shut in gas well 1 mcf/gpd


J. G. McGEHEE

Sec. 22 Twp. 15 R. 12W

Well No. #1 Jaune Farm
Fleming & Woodman Company

Fleming & Woodman Contractor
Hall-Gurney Pool

Ft. from N. Line
330 Ft. from S. Line
Ft. from E. Line
990 Ft. from W. Line

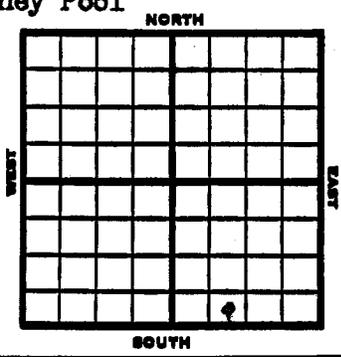

SE SW SE

1953 Elev. 1864' REPORT

7/22 Spud 7-19-53
8" @ 126'
WOC

9/23 500A, 1 M gas

9/30 Spud 7-19-53 Gas well TD 3333'
8" @ 126 Anhy 760 Heeb 2916
Dodge 2937 Br lime 3004 Lans 3016
DST 3023-98 open 1/2 hr rec 190' GCM
120' 0 & GCM 920#
DST 3194-3210 open 1/2 hr rec 15' mud
& VSSO 390# Cong. 3289
DST 3294-3314 open 55 min rec 97' OCM
TD 3314 5" @ 3299 DD 3333 PB 3200
24/3158-66 15/3160-65 500 A
S/4 BFPH 85% wtr. 8 hr.
PB 3230' 24/3086-75 wtr. SP 3070
24/3041-48 wtr. & gas 500 A
Comp. shut in gas well 1 MCFGPD

COMPLETED

Section 22 Township 15 Range 12W

Well No. #4 Jaune
Company Fleming & Woodman

