Form 26 200 Bks 5-42 Petrol Russell

KANSAS

Map No. 39 Sec. 23 Twp. 15 R. 12W

Well No. 1 K. Janne

Cities Service Oil Company

FIRST REPORT Contractor

C NE SE


SECTION PLAT

510 Ft. from N. Line

____ Ft. from S. Line

510 Ft. from E. Line

____ Ft. from W. Line

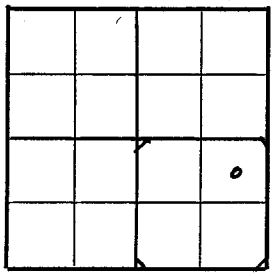

Forrest Hill Pool

Location X

Rig up

Drilling and Remarks:

RECORD

Cased ____ in., ____ ft.

Sand

Gas

Oil

Total Depth

PRODUCTION

1st 24 hrs. Nat.

1st 24 hrs. after shot

Gas ____ Cu. Ft.

Dry Hole

Abandoned

Date

DEC 2 9 1943 19 S. J. LEWIS Scout

Form 26 200 Bks 5-42 Petrol Russell

KANSAS

Map No. 85 Sec. 23 Twp. 15 R. 12W

Well No. 1 K. Janne

Cities Service Oil Company

ABANDONED Contractor

C NE SE


SECTION PLAT

510 Ft. from N. Line

____ Ft. from S. Line

510 Ft. from E. Line

____ Ft. from W. Line

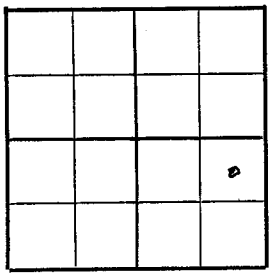

Forrest Hill Pool

Location

Rig up

Drilling and Remarks:

Comp 9343

TD 9327

RECORD

Cased ____ in., ____ ft.

Sand

Gas

Oil

Total Depth 9357

PRODUCTION

1st 24 hrs. Nat.

1st 24 hrs. after shot

Gas ____ Cu. Ft.

Dry Hole

Abandoned

Date

JAN 1 9 1944 19 S. J. LEWIS Scout

FORM 252-A
5M 9-43 GASS KANSAS

Russell

Sec. 23 Twp. 15 R. 12-W

Well No. #1 K. Janne Farm

Cities Service Oil Company

C NE SE


510 Ft. from N. Line

Ft. from S. Line

510 Ft. from E. Line

Ft. from W. Line

Elev. 1845

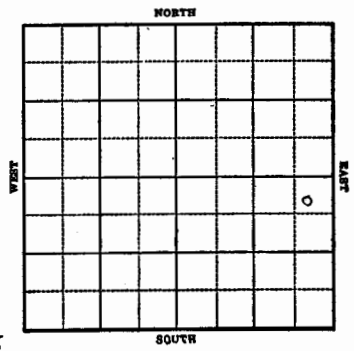

1943	REPORT
12-29	Location
1944	
1-5	8" @ 256 Drlg 1625'
1-12	Drlg 3247'
1/19	Cong 3303 Arb 3327 TD 3357'
	ABANDONED

KANSAS

Russell

FORM 51 5M.PETROL

Section 23 Township 15 Range 12W

Well No. #1 K. Janne

Company Cities Service Oil

Forrest Hill Pool

