

County Russell State Kansas

Sec. 24 (Blk. 15) (Sur. 12W) Map No.

Operator Fleming & Woodman & D. J. Iannitti

Well No. 2 Farm Janne "A"

Elev. _____ Location NW NE NE

FIRST REPORT

330 Ft. From N Line NE

990 Ft. From E Line Quarter

1st. Report MAR 23 1955

Completion _____

Remarks Ferrell - Contr.

Spudding Date _____

Drlg. Data

M I R

FABEN GILSTRAP

County Russell State Kansas

Sec. 24 (Blk. 15) (Sur. 12W) Map No.

Operator Fleming & Woodman & D. J. Iannitti

Well No. 2 Farm Janne "A"

Elev. 1865 Location NW NE NE

COMPLETE

330 Ft. From N Line NE

990 Ft. From E Line Quarter

1st. Report _____

Completion APR 27 1955

Remarks Ferrell - Contr.

Spudding Date 3-23-55

Drlg. Data

Oil well TD 3316

8" @ 205 Anhy 740 Heeb. 2910

Br. lime 3000 Lans. 3007 DST 3012-92

open 1 hr. Rec. 30' mud 0# DST 3185-3205 open 1 hr. Rec. 60' hocom 850#

Cong. 3295 Arb. 3307 TD 3316

5" @ 3311 CO to 3316 S/ 2 boph 3 hr.

500 A Comp. 50 bopd

FABEN GILSTRAP

Russell KANSAS

SEC.	TWP.	R.
24	15	12 W
WELL NO.		
# 2 Janne "A"		
FARM		
COMPANY		
Fleming & Woodman & D.J. Iannitti		
CONTRACTOR		
Ferrell		


330 Ft. from N. Line

Ft. from S. Line

990 Ft. from E. Line

Ft. from W. Line

NW NE NE

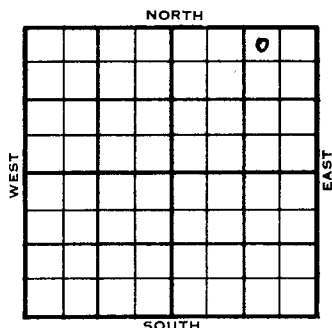

1955	ELEVATION 1865'	REPORT
3/23	MIR	
4/27	Spud 3-23-55 Oil Well TD 3316' 8" @ 205' Anhy 740' Heeb. 2910' Br. Line. 3000' Lans. 3007' DST 3012'-92' opn 1 hr, rec 30' Mud 0# DST 3185'-3205' opn 1 hr, rec 60' hocm 850# Cong. 3295', Arb. 3307' TD 3316' 5" @ 3311' CO to 3316 S/ 2 boph 3 hr. 500 A Comp 50 bopd.	
COMPLETED		

DX-78

DX 78-1

Russell

KANSAS

Section 24 Township 15 Range 12W

Well No. #2 Janne "A"

Company Fleming & Woodman & D.J. Iannitti

