

County <b>Russell</b> Elev. _____				Co.
Sec. <b>24</b> Twp. <b>15</b> Rge. <b>12W</b>				
Company <b>S &amp; S Pet.</b>				
FarmName <b>Janne</b> No. <b>2</b>				
Loc. in Sec. _____				
TOPS	DEPTH	LOG	DATUM	L S e c.
Anb.				
Tr.				
H.				
Tr.				
Dg.				
Bl.				
L.				
K.C.				
B.K.C.				
Ce.				
C.				
M.				
M.				
K.				
Mz.				
Me.				
V.				
S.				
A.				
R.				
Pe.				
G.				
TR.				

C SW NW

Geol. \_\_\_\_\_  
 Contr. \_\_\_\_\_  
**Isern Drlg.**  
 Pool \_\_\_\_\_  
**Janne**

AUG 24 1955  
**FIRST REPORT**

Date Comm. \_\_\_\_\_

**Location**

County <b>Russell</b> Elev. <b>1860</b>				Co.
Sec. <b>24</b> Twp. <b>15</b> Rge. <b>12W</b>				
Company <b>Stull &amp; Stonger Pet.</b>				
FarmName <b>Janne</b> No. <b>2</b>				
Loc. in Sec. _____				
TOPS	DEPTH	LOG	DATUM	L S e c.
Anb.				
Tr.				
H.	<b>2908</b>		<b>1048</b>	
Tr.	<b>2922</b>		<b>1062</b>	
Dg.				
Bl.	<b>2995</b>		<b>1135</b>	
L.	<b>3007</b>		<b>1147</b>	
K.C.				
B.K.C.				
Ce.				
C.	<b>3296</b>		<b>1436</b>	
M.				
M.				
K.				
Mz.				
Me.				
V.				
S.				
A.	<b>3350</b>		<b>1490</b>	
R.				
Pe.				
G.				
TR.	<b>3360</b>			

C SW NW

Geol. \_\_\_\_\_  
 Contr. \_\_\_\_\_  
**Isern Drlg.**  
 Pool \_\_\_\_\_  
**Janne**

**ABANDONED**

Date Comm. **8/25/55** **SEP 7 1955**

**8 5/8" 222 w/125 DST 2840-65 Rec. 200'**  
**mud BHP 750# 20" DST 3036-50 open 1 hr.**  
**Rec. 90' mud BHP 0# 20" no log**  
**D & A**

Russell

KANSAS

SEC.	24	TWP.	15	R.	12W
------	----	------	----	----	-----

WELL NO. #2 Janne

COMPANY S & S Pet. FARM

CONTRACTOR Isern Drlg

Janne


\_\_\_\_\_ Ft. from N. Line

\_\_\_\_\_ Ft. from S. Line

\_\_\_\_\_ Ft. from E. Line

\_\_\_\_\_ Ft. from W. Line

C SW NW

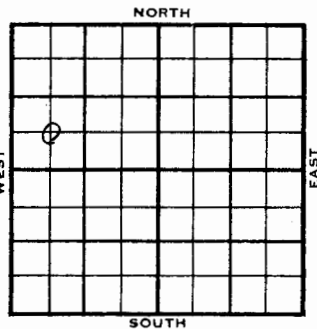

1955	ELEVATION	1860'	REPORT
------	-----------	-------	--------

8/24 Location

9-7 8 5/8" @ 222 w/125  
 DST 2840-65, rec 200' mud, BHP 750# 20"  
 DST 3036-50, open 1 hr., rec. 90' mud  
 BHP 0# 20" no log

D & A

TOPS	DEPTH
H.	2908
Tr.	2922
B.L.	2995
L.	3007
C.	3296
A	3350

T.D. 3360'

**ABANDONED**

DX-78

DX 78-1

Russell

KANSAS

Section 24 Township 15 Range 12 W

Well No. #2 Janne

Company S & S Pet.

