Form 26 200 Bks 5-42 Petrol **Russell**

Map No. JJ Sec. 24 Twp. 15 R. 12W


Well No. 1 Janne

Nadel & Gussman Company

FIRST REPORT Contractor

C W L SW NW

SECTION PLAT

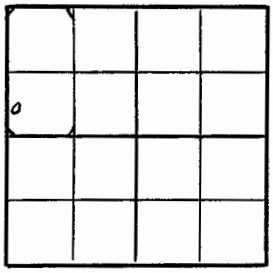

Ft. from N. Line

660 Ft. from S. Line

Ft. from E. Line

330 Ft. from W. Line

Forrest Hill Pool

Location

Rig up

Drilling and Remarks:

Rotary

RECORD

Cased in., ft.

Sand

Gas

Oil

Total Depth

PRODUCTION

1st 24 hrs. Nat.

1st 24 hrs. after shot

Gas Cu. Ft.

Dry Hole

Abandoned

Date

DEC 1 1943 19 S. J. LEWIS Scout

Form 26 200 Bks 5-42 Petrol **Russell**

KANSAS

Map No. JJ Sec. 24 Twp. 15 R. 12 W


Well No. 1 Janne

Nadel & Gussman Company

COMPLETED Contractor

C W L SW NW

SECTION PLAT

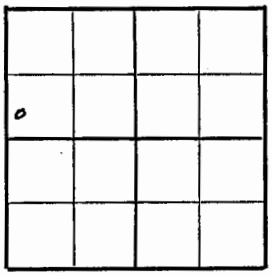

Ft. from N. Line

660 Ft. from S. Line

Ft. from E. Line

330 Ft. from W. Line

Forrest Hill Pool

Location

Rig up

Drilling and Remarks:

Gr Y 8308

5 C 3308.

5000 acid C

Pump. 143 BH

382 Gr

RECORD

Cased in., ft.

Sand

Gas

Oil

Total Depth 3344

PRODUCTION

1st 24 hrs. Nat.

1st 24 hrs. after shot

Gas Cu. Ft.

Dry Hole

Abandoned

Date

MAR 1 1944 19 S. J. LEWIS Scout

FORM 252-A
5M 9-43 GABS


KANSAS

Russell

Sec. 24 Twp. 15 R. 12-W

Well No. #1 Janne Farm

Nadel & Gussman Company

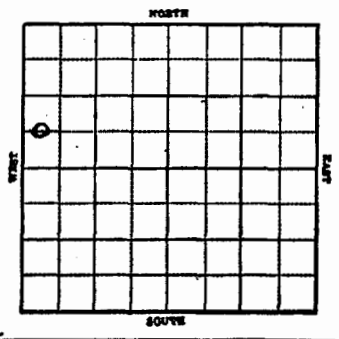

____ Ft. from N. Line

660 Ft. from S. Line

____ Ft. from E. Line

330 Ft. from W. Line

Elev. 1862

1943	REPORT
12/1	Rotary
12/8	8" @ 507 Drlg. 1685'
12-15	Lans 3038' Coring 3040'
12/22	Arb 3308-10 TD Sat 5" @ 3308 Rust
12/29	SO 3319-21½ TD 1 oil per hr
1944	
1-5	TD 3330 2000 acid
1-12	31 shots 3088-3106 2000 acid
1/19	To squeeze
1/26	TD 3330 Corrected.
2/2	" " "
2/8	Pump 10 oil per hr 4 hrs.
2/15	" " " "
2/23	" " " "

OVER

1944

3/1 Arb 3308
TD 3344'
5" @ 3308'
5000 acid
Pump 143 Pot.
Gravity 38.7

COMPLETED

KANSAS Russell

FORM 51 5M PETROL

Section 24 Township 15 Range 12 W

Well No. #1 Jamo

Company Nadel & Gussman

