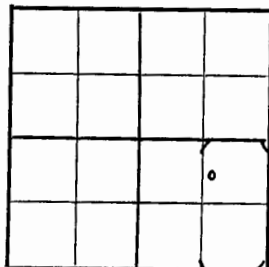


Russell

Map No. 55 Sec. 24 Twp. 15 R. 12WWell No. 1 HeinzeLauck & Moncrief CompanyFIRST REPORT Contractor

C W L NE SE

SECTION PLAT

660 Ft. from N. Line

Ft. from S. Line

990 Ft. from E. Line

Ft. from W. Line

Janne Pool

Location

RECORD

Cased _____ in., _____ ft.

Sand _____

Gas _____

Oil _____

Total Depth _____

PRODUCTION

1st 24 hrs. Nat. _____

1st 24 hrs. after shot _____

Gas _____ Cu. Ft.

Dry Hole _____

Abandoned _____


Date

APR 5 1944 19 S. J. LEWIS ScoutPool Name Janne PoolMap No. 55 Sec. 24 Twp. 15 R. 12WWell No. 1 HeinzeLauck & Moncrief Company**ABANDONED**

Contractor

C W L NE SE

SECTION PLAT

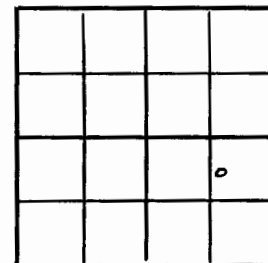660 Ft. from N. Line

Ft. from S. Line

990 Ft. from E. Line

Ft. from W. Line

Russell County

Location

RECORD

Cased _____ in., _____ ft.

Sand _____

Gas _____

Oil _____

Total Depth 3155

PRODUCTION

1st 24 hrs. Nat. _____

1st 24 hrs. after shot _____

Gas _____ Cu. Ft.

Dry Hole _____

Abandoned _____

Date

MAY 2 4 1944 19 S. J. LEWIS Scout

FORM 2
5
KANSAS

Russell

Sec. 24 Twp. 15 R. 12W

Well No. #1 Heinze Farm

Lauck & Moncrief Company


Janne Pool

660 Ft. from N. Line

Ft. from S. Line

990 Ft. from E. Line

Ft. from W. Line

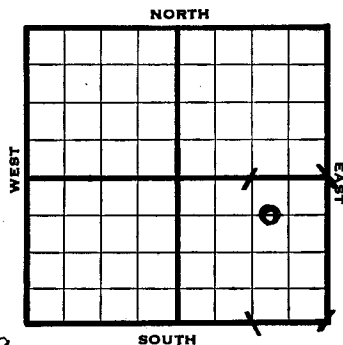

Ele. 1859

1944

REPORT

4/5

Derrick

4/12

10" @ 200
WOC.

4/19

2895' Drlg.

4/26

Lans 2996 SO 3028-32,
3024-38, 3089-3114
Cong 3298
Arb 3330-55 TD
No shows
5" @ 3158
Rust

5/3

"

5/10

"

5/17

Plug 3076

Perf. 3026-28 - 1000 acid
Small show oil & water

5/124

5" @ 3158
Arb 3330
T^D 3155
Water

ABANDONED

KANSAS
5M PETROL

Russell

Section 24 Township 15 Range 12W

Well No. #1 Heinze

Company Lauck & Moncrief

