

Kansas

Map No. _____ Sec. 27 Twp. 15 R. 12WWell No. 1 Klusener Brown B 1

Lewis Drlg.


Company

FIRST REPORT

Contractor

SE SW

SECTION PLAT

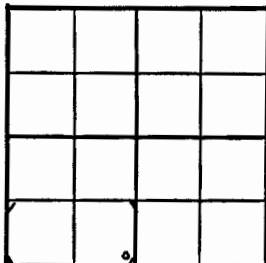

Ft. from N. Line

330 Ft. from S. Line330 Ft. from E. Line

Ft. from W. Line

Russell County

Location

Rig up

Drilling and Remarks:

R U R

RECORD

Cased _____ in., _____ ft.

Sand _____

Gas _____

Oil _____

Total Depth _____

PRODUCTION

1st 24 hrs. Nat. _____

1st 24 hrs. after shot _____

Gas _____ Cu. Ft.

Dry Hole _____

Abandoned _____

Date

MAY 4 1949 19 S. J. LEWIS Scout

Kansas

Map No. K55 Sec. 27 Twp. 15 R. 12WWell No. 1 Klusener Brown B 1

Lewis Drlg.


Company

COMPLETE

Contractor

SE SW

SECTION PLAT

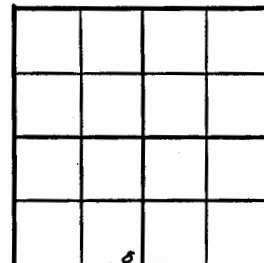

Ft. from N. Line

330 Ft. from S. Line330 Ft. from E. Line

Ft. from W. Line

Russell County

Location

Rig up

Drilling and Remarks:

Liam 2988

Quartzite 3260

5" 3264

Prof. 4 ans.

4000 cu. ft.

Prof. 25 in 1 ft.

38-3/4

RECORD

Cased _____ in., _____ ft.

Sand _____

Gas _____

Oil _____

Total Depth 3264

PRODUCTION

1st 24 hrs. Nat. _____

1st 24 hrs. after shot _____

Gas _____ Cu. Ft.

Dry Hole _____

Abandoned _____

Date

JUN 1 1949 19 S. J. LEWIS Scout

KANSAS

Russell

Sec. 27 Twp. 15 R. 12W

Well No. #1 Klusener Brown 'B' Farm

Lewis Drlg. Company

Meir Pool


Ft. from N. Line

330' Ft. from S. Line

330' Ft. from E. Line

Ft. from W. Line

SE SW

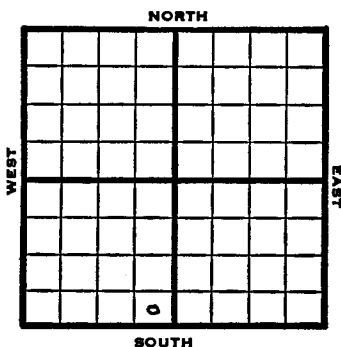

1949 Elev 1858' REPORT

5/4 RUR
5/10 8" @ 148'
Drlg 2225'
5/18 Lans/ 2988'
Quartzite 3260-64'
TD 3264'
5" @ 3260'
5/25 to perforate
6/1 TD 3264'
Lans. 2988'
Quartzite 3260'
5 @ 3264'
Perf. Lans.
4000 acid
Pump 75 Oil Pot
38° Gr.
Comp

COMPLETED

KANSAS

Russell

Section 27 Township 15 Range 12W

Well No. 1 Klusener Brown 'B' 1

Company Lewis Drlg.

Meir
NORTH

