

Map No. Sec. 27 Twp. 15 R. 12W

Well No. 3 Kuffman "B"

Harry Gore Company

FIRST REPORT Contractor

SW NW NW

SECTION PLAT

990 Ft. from N. Line
Ft. from S. Line
Ft. from E. Line
330 Ft. from W. Line

4x4 grid section plat

Russell County

Location

Rig up

Drilling and Remarks:

Rig

RECORD

Cased in, ft.
Sand
Gas
Oil
Total Depth

PRODUCTION

1st 24 hrs. Nat.
1st 24 hrs. after shot
Gas Cu. Ft.
Dry Hole
Abandoned

Date

FEB 26 1947 19 S. J. LEWIS Scout

Map No. K55 Sec. 27 Twp. 15 R. 12W

Well No. 3 Kuffman "B"

Harry Gore Company

COMPLETE Contractor

SW NW NW

SECTION PLAT

990 Ft. from N. Line
Ft. from S. Line
Ft. from E. Line
330 Ft. from W. Line

4x4 grid section plat

Russell County

Location

Rig up

Drilling and Remarks:

Oil 43220
5' @ 3220
Pump 176 ft

40 2/3

RECORD

Cased in, ft.
Sand
Gas
Oil
Total Depth 3222

PRODUCTION

1st 24 hrs. Nat.
1st 24 hrs. after shot
Gas Cu. Ft.
Dry Hole
Abandoned

Date

MAY 14 1947 19 S. J. LEWIS Scout

KANSAS

Russell ✓

Sec. 27 Twp. 15 R. 12-W

Well No. #3 Kuffman "B" Farm

Harry Gore Company


Hall-Gurney

990 Ft. from N. Line

Ft. from S. Line

Ft. from E. Line

330 Ft. from W. Line

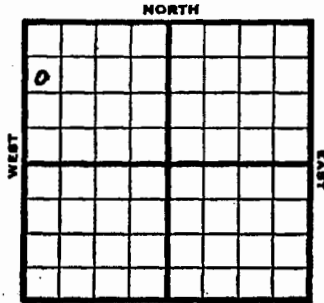

5/14

Arb. 3220'
5" @ 3220'
Pump 176 Pot
40.0 Gr.
TD 3222

COMPLETED

SW NW NW

Elev. 1762'

SOUTH

REPORT

1947	
2/26	Rig
3/4	"
3/11	
3/18	Rig
3/25	10" @ 675' Anhy 675' Drlg 800'
4/2	Drlg. 1970'
4/9	8" @ 1995' Drlg 2335'
4/15	8" @ 2376' Topaka 2550' Drlg. 2650'
4/23	Lans 2935 Drlg 3070'
4/29	Arb 3220-22 TD 3222' 5" @ 3220' WCC
5/7	2000' oil in 20 hrs

OVER

Russell County

Hall-Gurney

FORM 51 IOM 12-46 PETROL

KANSAS

Section 27 Township 15 Range 12W

Well No. 3 Kuffman "B"

Company Harry Gore

