

KANSAS Kansas Pool Name Hall-Gurney

Hall-Gurney

Map No. 55 Sec. 27 Twp. 15 R. 12W

Map No. 55 Sec. 27 Twp. 15 R. 12W

Well No. 2 Kauffman "B"

Well No. 2 Kauffman "B"

Harry Gore Company

Harry Gore Company

**FIRST REPORT**

**COMPLETED**

Contractor

Contractor

NE NW NW

NE NW NW

SECTION PLAT

E. 1761  
SECTION PLAT

330 Ft. from N. Line

330 Ft. from N. Line

\_\_\_\_\_ Ft. from S. Line

\_\_\_\_\_ Ft. from S. Line

\_\_\_\_\_ Ft. from E. Line

\_\_\_\_\_ Ft. from E. Line

990 Ft. from W. Line

990 Ft. from W. Line

o			

o			

Russell County

Russell County

Location X

Location \_\_\_\_\_

RECORD

RECORD

Cased \_\_\_\_\_ in., \_\_\_\_\_ ft.

Cased \_\_\_\_\_ in., \_\_\_\_\_ ft.

Rig up \_\_\_\_\_

Rig up \_\_\_\_\_

Sand \_\_\_\_\_

Sand \_\_\_\_\_

Drilling and Remarks:

Drilling and Remarks:

Gas \_\_\_\_\_

Gas \_\_\_\_\_

Oil \_\_\_\_\_

Oil \_\_\_\_\_

Total Depth \_\_\_\_\_

Total Depth 3208

PRODUCTION

PRODUCTION

1st 24 hrs. Nat. \_\_\_\_\_

1st 24 hrs. Nat. \_\_\_\_\_

1st 24 hrs. after shot \_\_\_\_\_

1st 24 hrs. after shot \_\_\_\_\_

Gas \_\_\_\_\_ Cu. Ft.

Gas \_\_\_\_\_ Cu. Ft.

Dry Hole \_\_\_\_\_

Dry Hole \_\_\_\_\_

Abandoned \_\_\_\_\_

Abandoned \_\_\_\_\_

Date

Date

JUL 3 1946 S. J. LEWIS Scout

OCT 1 6 1946 S. J. LEWIS Scout

*Leas 2915  
7" CB/96  
Bd. hams 3201  
Pump 240 BT  
40°/42*

KANSAS

Russell County ✓

Sec. 27 Twp. 15 R. 12W

Well No. #2 Kauffman "B" Farm

Harry Gore Company

Hall-Gurney


380 Ft. from N. Line

\_\_\_\_\_ Ft. from S. Line

\_\_\_\_\_ Ft. from E. Line

990 Ft. from W. Line

NE NW NW

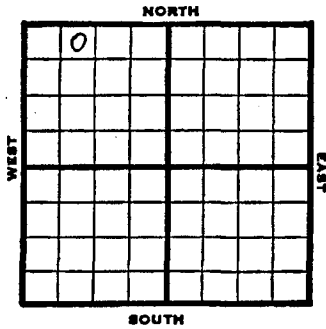

1946

10/16 Lans 2915  
7" @ 3196'  
TD 3208'  
Gorham 3201'  
Pump 240 POT  
Grav. 40

**COMPLETED**

1946	1761	REPORT
7/3		Location
7/9		Rig
7/16		"
7/23		"
7/30		12" @ 370' Drlg 600'
8/6		Anhy 664 Drlg 1275'
8/13		10" @ 675 Drlg 1905'
8/20		8" @ 2375 Drlg 2378'
8/27		8" @ 2493 Drlg 2790'
9/5		Lans 2915 Drlg 3088'
9/10		7" @ 3080 3190 HR 7"
9/18		7" @ 3196' TD 3201' WOC
9/24		TD3208' Pump 184 oil in 16 hrs
10/1		" " "
10/8		" " "

OVER

KANSAS

FORM 51 5M 6-46 PETROL

Russell

Section 27 Township 15 Range 12W

Well No. 2 Kauffman "B"

Company Harry Gore

