

KANSAS

Pool Name Forrest HallMap No. 55 Sec. 27 Twp. 15 R. 12WWell No. 1 Kufman

Harry- Gore Company

FIRST REPORT

Contractor

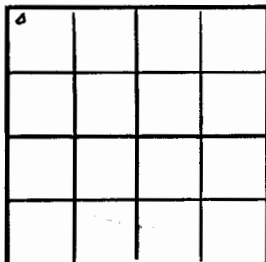
NW/c

SECTION PLAT

330 Ft. from N. Line

Ft. from S. Line

Ft. from E. Line

330 Ft. from W. Line

Russell County

Location X

Rig up

Drilling and Remarks:

RECORD

Cased _____ in., _____ ft.

Sand _____

Gas _____

Oil _____

Total Depth _____

PRODUCTION

1st 24 hrs. Nat. _____

1st 24 hrs. after shot _____

Gas _____ Cu. Ft.

Dry Hole _____

Abandoned _____

Date

AUG 1 1945

19

S. J. LEWIS

Scout

KANSAS

Kansas

Pool Name Forrest HillMap No. 55 Sec. 27 Twp. 15 R. 12WWell No. 1 Kufman

Harry Gore Company

COMPLETED

Contractor

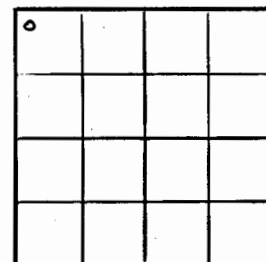
NW/c

SECTION PLAT

330 Ft. from N. Line

Ft. from S. Line

Ft. from E. Line

330 Ft. from W. Line

Russell County

Location _____

Rig up _____

Drilling and Remarks:

Per 832022' 03202Pump 450 PS36 2/3

RECORD

Cased _____ in., _____ ft.

Sand _____

Gas _____

Oil _____

Total Depth 3204

PRODUCTION

1st 24 hrs. Nat. _____

1st 24 hrs. after shot _____

Gas _____ Cu. Ft.

Dry Hole _____

Abandoned _____

Date

OCT 2 4 1945

19

S. J. LEWIS

Scout

KANSAS

Russell

Sec. 27 Twp. 15 R. 12-W

Well No. #1 Kufman Farm

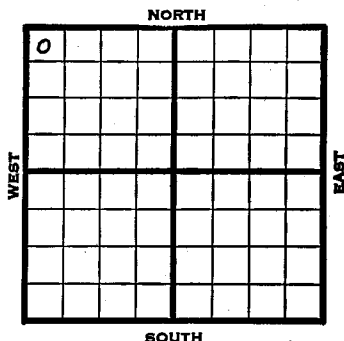
Harry-Gore Company

330 Ft. from N. Line

Ft. from S. Line

Ft. from E. Line

330 Ft. from W. Line



NW/4 Elev. 1759

REPORT

1945

Location

8/1

"

8/8

"

8/15

"

8/22

8/29

15" @ 40

Drlg. 435

9/5

10" @ 662

Anhy 652

Drlg. 1620

9/12

8" @ 1950

Drlg. 2070'

9/19

8" @ 2365

Drlg. 2440

9/26

Dodge 2842

Drlg. 2887'

10/3

Dans 2909

6" @ 3040

Drlg. 3043

10/10

6" @ 3140

Drlg. 3156'

10/17

Arb. 3202

7" @ 3202

TD 3204 1500' oil 12 hrs.

10/24

Arb. 3202

7" @ 3202

TD 3204

Pump 480 Pot.

Grav. 36.7

COMPLETED

KANSAS

Russell

Section 27 Township 15 Range 12W

Well No. 1 Kufman

Company Harry-Gore

