

Map No. _____ Sec. 27 Twp. 15 R. 12W

Well No. 5 Brown

Lewis Drlg. _____ Company

Lewis Drlg. _____ Contractor

C N L SW SW

FIRST REPORT
SECTION PLAT

_____ Ft. from N. Line

990 _____ Ft. from S. Line

_____ Ft. from E. Line

660 _____ Ft. from W. Line

Russell County

Location _____

Rig up _____

Drilling and Remarks:

8" @ 450

RECORD

Cased _____ in., _____ ft.

Sand _____

Gas _____

Oil _____

Total Depth _____

PRODUCTION

1st 24 hrs. Nat. _____

1st 24 hrs. after shot _____

Gas _____ Cu. Ft.

Dry Hole _____

Abandoned _____

Date

NOV 16 1949

19

S. J. LEWIS

Scout

Map No. _____ Sec. 27 Twp. 15 R. 12W

Well No. 5 Brown

Lewis Drlg. _____ Company

~~ABANDONED~~ _____ Contractor

C N L SW SW

~~E11778~~
SECTION PLAT

_____ Ft. from N. Line

990 _____ Ft. from S. Line

_____ Ft. from E. Line

660 _____ Ft. from W. Line

Russell County

Location _____

Rig up _____

Drilling and Remarks:

Cur 3254

RECORD

Cased _____ in., _____ ft.

Sand _____

Gas _____

Oil _____

Total Depth *3200*

PRODUCTION

1st 24 hrs. Nat. _____

1st 24 hrs. after shot _____

Gas _____ Cu. Ft.

Dry Hole _____

Abandoned _____

Date

DEC 21 1949

19

S. J. LEWIS

Scout

Sec. 27 Twp. 15 R. 12W

Well No. #5 Brown Farm _____
Lewis Drlg. Company _____

Dubuque Pool (Lewis Drlg., Contr.) NORTH


_____ Ft. from N. Line

990' Ft. from S. Line

_____ Ft. from E. Line

660' Ft. from W. Line

C N L SW SW

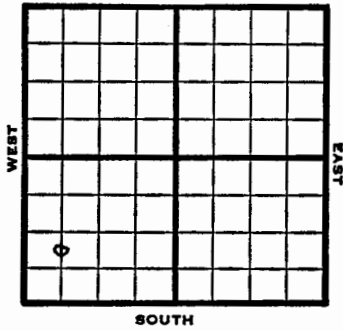

1949 Elev 1778 REPORT

- 11/16 8" @ 450'
- 11/23 Drlg 2843'
- 11/29 Lansing 2936'
 Arb. 3254'
 TD 3300
 5" @ 3275'
- 12/7 "
- 12/14 "
- 12/21 TD 3300'
 Arb. 3254'
 Aband.

ABANDONED

Section 27 Township 15 Range 12W

Well No. #5 Brown

Company Lewis Drlg
Dubuque Pool NORTH

