

Map No. _____ Sec. 27 Twp. 15 R. 12W

Well No. 3 Klusener

Lewis Drlg. _____ Company

Lewis Drlg. _____ Contractor

NW SE SW

FIRST REPORT
SECTION PLAT

_____ Ft. from N. Line

990 _____ Ft. from S. Line

990 _____ Ft. from E. Line

_____ Ft. from W. Line

Russell County

Location _____

Rig up _____

Drilling and Remarks:

1800

RECORD

Cased _____ in. _____ ft.

Sand _____

Gas _____

Oil _____

Total Depth _____

PRODUCTION

1st 24 hrs. Nat. _____

1st 24 hrs. after shot _____

Gas _____ Cu. Ft.

Dry Hole _____

Abandoned _____

Date

JUL 27 1949

19

S. J. LEWIS

Scout

Map No. K55 Sec. 27 Twp. 15 R. 12W

Well No. 3 Klusener

Lewis Drlg. _____ Company

COMPLETE _____ Contractor

NW SE SW

SECTION PLAT

_____ Ft. from N. Line

990 _____ Ft. from S. Line

_____ Ft. from E. Line

990 _____ Ft. from W. Line

Russell County

Location _____

Rig up _____

Drilling and Remarks:

Lans 2889

Quartzite 3212

5" 3212

Ref. Lans.

4000 and

Pump 60 in. Pdt

28-34

RECORD

Cased _____ in. _____ ft.

Sand _____

Gas _____

Oil _____

Total Depth 3212

PRODUCTION

1st 24 hrs. Nat. _____

1st 24 hrs. after shot _____

Gas _____ Cu. Ft.

Dry Hole _____

Abandoned _____


Date

AUG 24 1949 19

S. J. LEWIS

Scout

County Russell State Kansas
 Sec. 27 (Blk. 15) (Sur. 12W) Map No.
 Operator Lewis Drlg.
 Well No. 3 Farm Brown
 Elev. 1810 Location NW SE SW

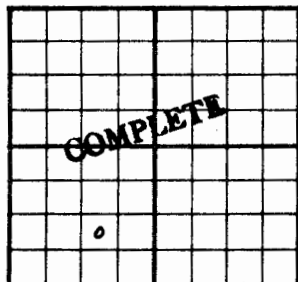

990 Ft. From S Line SW
 990 Ft. From W Line Quarter
 1st. Report 7-27-49
 Completion 8-24-49
 Remarks Neier Pool

Spudding Date

Drlg. Data Oil well TD 3212
8" @ 162 Anhy 732 Heeb. 2851
Lans. 2939 Quartzite 3212 5" @ 3212
73/ 3123-33 4000 A S/ 30 bopd
Comp. 60 bopd

J. E. TYRA

County Russell State Kansas
 Sec. 27 (Blk. 15) (Sur. 12W) Map No.
 Operator Lewis Drlg.
 Well No. 3 Farm Brown
 Elev. Location NW SE SW




990 Ft. From S Line SW
 990 Ft. From E Line Quarter
 1st. Report APR 18 1951
 Completion
 Remarks O.W.B. P.B.

Spudding Date

Drlg. Data Dubuque Pool
Heeb. 2851 Lans. 2939 OTD 3212
5" @ 3212 Top, 2610 SP 2830 48/ 2794-
2705 80 to acidise

J. E. TYRA

County Russell State Kansas
 Sec. 27 (Blk. 15) (Sur. 12W) Map No.
 Operator Lewis Drlg.
 Well No. 3 Farm Brown
 Elev. 1810 Location NW SE SW

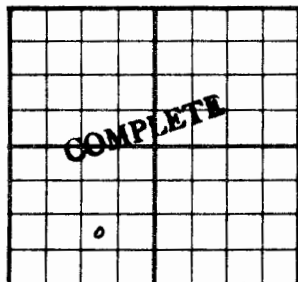

990 Ft. From S Line SW
 990 Ft. From W Line Quarter
 1st. Report 7-27-49
 Completion 8-24-49
 Remarks Neier Pool

Spudding Date

Drlg. Data Oil well TD 3212
8" @ 162 Anhy 732 Heeb. 2851
Lans. 2939 Quartzite 3212 5" @ 3212
73/ 3123-33 4000 A S/ 30 bopd
Comp. 60 bopd

J. E. TYRA

County Russell State Kansas
 Sec. 27 (Blk. 15) (Sur. 12W) Map No.
 Operator Lewis Drlg.
 Well No. 3 Farm Brown
 Elev. Location NW SE SW



990 Ft. From S Line SW
 990 Ft. From E Line Quarter
 1st. Report APR 18 1951
 Completion
 Remarks O.W.B. P.B.

Spudding Date

Drlg. Data Dubuque Pool
Heeb. 2851 Lans. 2939 OTD 3212
5" @ 3212 Top. 2610 SP 2830 48/ 2794-
2705 80 to acidise

J. E. TYRA

KANSAS

Russell

Sec. 27 Twp. 15 R. 12W ✓

Well No. 3 ~~Krusener~~ ^{BROWN} O. W. P. B. Co.

Lewis Drlg. Company

Neier Pool


Lewis Drlg. Contr. NORTH

Ft. from N. Line

990 Ft. from S. Line

990 Ft. from E. Line

990 Ft. from W. Line

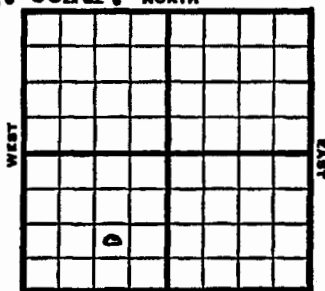

NW SE SW

SOUTH

1952

2/?

F.R. 7-27-49

Comp. 8-24-49

Oil Well TD 3212

8 @ 162

Any 732 Heeb. 2851 Lans. 2929

Quartzite 3212

5" @ 3212 73/ 3123-33

4000 A S/ 30 bopd Comp. 60 bppd

COMPLETED

1949 Elev 1810' REPORT

7/27 1800 Drlg.

8/3 8" @ 162'

Drlg 3045'

8/10 Lansing 2939'

Quartzite 3212'

5" @ 3212'

8/17 73 shots 3123-33

4000 acid

Swb 30 bbls oil a day

8/24 TD 3212'

Lans 2939'

Quartzite 3212'

5" @ 3212

Perf Lans

4000 acid

Pump 60 Oil Pot

38° Gr.

Comp

COMPLETED

1951 O. W. P. B.

4/18 Heeb. 2851'

Lans. 2939'

OTD 3212' 5" @ 3212'

Top 2610',

SP 2830' 48/2794-2705 SO

1952 To acidize

2/6 NR

OVER

KANSAS Russell
SO. W. P. B.

Section 27 Township 15 Range 12W

Well No. 3 ^{Brown}~~Klusener~~

Company Lewis Drlg.

Neier
NORTH

